

JAN 19 2000

LIBER 333 PAGE 448

SECTION

LAND CORNER RECORDATION CERTIFICATE

Filing Requirement of Act 74, Mich. P.A. 1970

1361

For corners in

Missaukee County Located In: Corner Code #
(County)

1. Public Land Survey T 21N R 8W I-11
T R
T R
T R

2. Property Controlling S T R
in Section S T R

3. Miscellaneous S T R
Property in Sec. S T R

MISSAUKEE COUNTY MICHIGAN

RECORDED DEC 09 1999 4:10 PM

Register of Deeds Stamp & File Number

4. Lot No. , Recorded Plat
5. Private Claims

I, Daniel E. Schripsema, in a field survey on October 1, 1999 do hereby state that under requirements of P.A. 74, Michigan P.A. of 1970, the corner points mentioned in lines 1 and 2 above were in conformance with regulations and rules therefore as required in the current manual of survey instructions of the United States Department of the Interior, Bureau of Land Management or by a decree of a Court of Law and /or that the corner points mentioned in lines 3, 4 and 5 above were in conformance with the rules of the Michigan Board of Land Surveyors or by a Decree of a Court of Law; established, re-established, monumented, recovered, found as expressed below:

NOTE: Not more than 2 corners, all in the same town and range, may be recorded on this certificate.

A. Description of original monument and accessories and/or subsequent restoration:

I-11 - GLO - Set Post
16" Sugar N.63 1/2 E.27
- Record Survey - L. S-3, Page 57 - Daniel E. Schripsema - May 14, 1991
Fd. 1" Steel Bar
N53W - 63.90 - 4"x4" Post
N41E - 67.67 - Fence Post
S50W - 52.58 - center Sign
S25E - 78.43 - P. Pole

B. Description of corner evidence found and/or method applied in restoring or reestablishing corner:


Found 1" steel bar. This corner is accepted as the best available evidence of the position of the original corner.

C. Description of monument for corner and accessories established to perpetuate locating the position of the corner:

Placed Missaukee County Monument on top of iron.

WITNESSES

N25W - 40.68- Corner Fence Post
N65W - 79.43 - 6" Elm
N50E - 54.58 - Power Pole
S25E - 78.43 - Power Pole (fd. Spike)
East - 7.25 - Railroad Spike

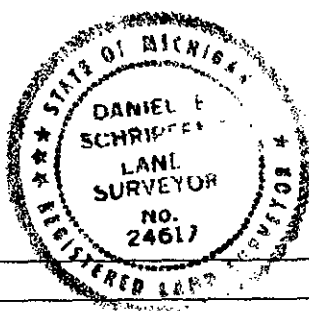

Signed by [Signature] Surveyor's Michigan License No. 24617

Peer Group Reviewed and Approved

Date: 12-2-99 J. Dean Geers, Missaukee Co. Representative

Date 12-2-99