

JAN 19 2000

LIBER 333 PAGE 445

## SECTION

## LAND CORNER RECORDATION CERTIFICATE

# 1358


Filing Requirement of Act 74, Mich. P.A. 1970

For corners in

<u>Missaukee County</u> (County)	Located In:	Corner Code #
1. Public Land Survey	T 21N R 8W	I-12
	T R	
	T R	
	T R	
2. Property Controlling in Section	S T R	
	S T R	
3. Miscellaneous	S T R	
Property in Sec.	S T R	

MISSAUKEE COUNTY MICHIGAN

RECORDED DEC 09 1999 4:18 PM

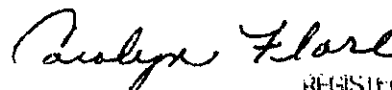

 REGISTERED  
 Register of Deeds Stamp & File  
 Number

 4. Lot No. \_\_\_\_\_, Recorded Plat \_\_\_\_\_  
 5. Private Claims \_\_\_\_\_

I, Daniel E. Schripsema, in a field survey on October 1, 1999 do hereby state that under requirements of P.A. 74, Michigan P.A. of 1970, the corner points mentioned in lines 1 and 2 above were in conformance with regulations and rules therefore as required in the current manual of survey instructions of the United States Department of the Interior, Bureau of Land Management or by a decree of a Court of Law and/or that the corner points mentioned in lines 3, 4 and 5 above were in conformance with the rules of the Michigan Board of Land Surveyors or by a Decree of a Court of Law; established, re-established, monumented, recovered, found as expressed below:

NOTE: Not more than 2 corners, all in the same town and range, may be recorded on this certificate.

A. Description of original monument and accessories and/or subsequent restoration:

I-12 - GLO - Set Post  
 16" Sugar S.15 E.39  
 12" Sugar N.15 W.21

B. Description of corner evidence found and/or method applied in restoring or reestablishing corner:


Set by single proration on line between I-11 and I-13. This corner is the best available evidence of the position of the original corner.

C. Description of monument for corner and accessories established to perpetuate locating the position of the corner:

Set 1/2" Iron w/ Remon Cap  $\pm$ 2' W. of Road Centerline

## WITNESSES

N85W	82.80'	Fd. Nail in Power Pole
N60E	51.41'	Set 1/2" Iron
N25W	50.95'	Set 1/2" Iron
S10E	82.90'	Set 1/2" Iron

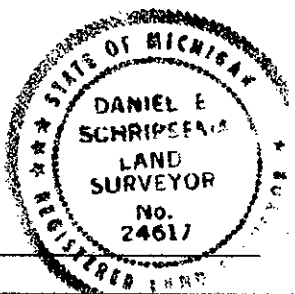

Peer Group Reviewed and Approved

Date: 12-9-99

J. Dean Geers, Missaukee Co. Representative

Signed by Daniel E. SchripsemaSurveyor's Michigan License No. 24617Date 12-2-99