

SURVEY &  
REMONUMENTATION

JAN 27 1999

LIBER 323 PAGE 1241

SECTION

LAND CORNER RECORDATION CERTIFICATE  
Filing Requirement of Act 74, Mich. P.A. 1970

#1292

For corners in

<u>Missaukee</u> (County)	Located In:	Corner Code #
1. Public Land Survey	T <u>22N</u> R <u>06W</u>	<u>L-13</u>
	T _____ R _____	_____
	T _____ R _____	_____
	T _____ R _____	_____
2. Property Controlling in Section	S _____ T _____ R _____	_____
	S _____ T _____ R _____	_____
3. Miscellaneous Property in Sec.	S _____ T _____ R _____	_____
	S _____ T _____ R _____	_____

MISSAUKEE COUNTY MICHIGAN

RECORDED NOV 13 1998 950 11 A.M.

Paulyn Flare  
REGISTER

Register of Deeds Stamp & File Number

4. Lot No. \_\_\_\_\_, Recorded Plat \_\_\_\_\_

5. Private Claims \_\_\_\_\_

I, J. Dean Geers, P.S., in a field survey on June, 19 98, do hereby state that under requirements of P.A. 74, Michigan P.A. of 1970, the corner points mentioned in lines 1 and 2 above were in conformance with regulations and rules therefore as required in the current manual of survey instructions of the United States Department of the Interior, Bureau of Land Management or by a decree of a Court of Law and/or that the corner points mentioned in lines 3, 4 and 5 above were in conformance with the rules of the Michigan Board of Land Surveyors or by a Decree of a Court of Law; established, re-established, monumented, recovered, found as expressed below:

NOTE: Not more than 2 corners, all in the same town and range, may be recorded on this certificate.

	A	B	C	D	E	F	G	H	I	J	K	L	M
1													
2		6		5		4		3		2		1	
3													
4		7		8		9		10		11		12	
5													
6		18		17		16		15		14		13	
7													
8		19		20		21		22		23		24	
9													
10		30		29		28		27		26		25	
11													
12		31		32		33		34		35		36	
13													

A. Description of original monument and accessories and/or subsequent restoration:

L-13) 1837 GLO Quarter Section Post by John Brink, Deputy Surveyor; Cedar 10-N42½E-27, Cedar 8-N20W-37

B. Description of corner evidence found and/or method applied in restoring or reestablishing corner:

L-13) Quarter Section Corner common to Section 36, T22N, R6W and Section 1, T21N, R6W; Re-established corner midway and on line between the section corner to the East and West. This corner is accepted as the best available evidence of the position of the original corner.

C. Description of monument for corner and accessories established to perpetuate locating the position of the corner:

L-13) Set 5/8" x 36" Rebar with Missaukee County Monument inside of a 1" pipe.

S20E	22.80	8" Cedar
S72E	11.82	5" Ash
S72W	8.79	5" Ash
S65W	33.35	14" Ash


Peer Group Reviewed and Approved

Date: 10-2-98

J. Dean Geers  
J. Dean Geers, Missaukee Co. Representative

Signed by

Surveyor's Michigan License No. \_\_\_\_\_

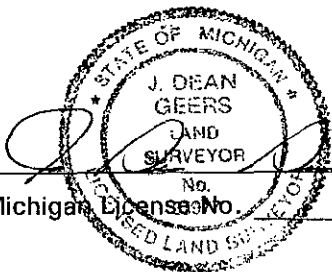

Date 11-2-98