

**LAND CORNER RECORDATION CERTIFICATE**  
**Filing Requirement of Act 74, Mich. P.A. 1970**

For corners in

MISSAUKEE

(County)

Located In:

Corner Code //

1. Public Land Survey

T 23N R 05W

I-4, I-5

T R

T R

T R

2. Property Controlling  
in Section

S 10 T 23N R 05W

13, 14

S T R

3. Miscellaneous

S T R

Property in Sec.

S T R

Register of Deeds Stamp & File Number

4. Lot No. , Recorded Plat

5. Private Claims

I, CARL F. ROSER, in a field survey on APRIL 15, 19 86

do hereby certify that under requirements of P.A. 74, Michigan P.A. of 1970, the corner points mentioned in lines 1 and 2 above were in conformance with regulations and rules therefore as required in the current manual of survey instructions of the United States Department of the Interior, Bureau of Land Management or by a decree of a Court of Law and/or that the corner points mentioned in lines 3, 4 and 5 above were in conformance with the rules of the Michigan Board of Land Surveyors or by a Decree of a Court of Law; established, re-established, monumented, re-monumented, recovered, found as expressed below:

**NOTE: Not more than 4 corners, all in the same town and range, may be recorded on this certificate.**

C. (CONTINUED)

~~XXXXXXXXXXXXXXXXXXXX~~ and accessories and/or subsequent restoration:

14

DROVE 5/8" X 34" REROD W/RLS CAP

& SET CED POST W/LOC TAG.

23" R PINE N30°W 390.9'

42" R OAK N10°E 363.4'

	A	B	C	D	E	F	G	H	I	J	K	L	M
2	6	5	4	3	2	1							
3													
4	7	8	9	10	11	12							
5													
6	18	17	16	15	14	13							
7													
8	19	20	21	22	23	24							
9													
10	30	29	28	27	26	25							
11													
12	31	32	33	34	35	36							
13													

B. Description of corner evidence found and/or method applied in restoring or reestablishing corner:

I-4 PREV DEPT COR OF RECORD (K.J.O.-1967). KJO FD OLD IRON BEDPOST (BURIED) IN RD & IN LINE W/FN SOUTH. FITS E.A.BEUTHIEN 1912 & 1915 SUR IN SEC 11 & 1914 SUR IN SEC 10.

I-5 FD 3" X 3" X 42" SQ WOOD POST W/RLS CAP #21996. FITS KJO (1967) & E.A.BEUTHIEN (1914) DIST. N 1/2 MILE; AND FRED THOMSON (WILCOX & ASSOC.), E.A.B. & K.J.O. DIST E 1/2 MILE.

13 ESTAB CTR OF SE 1/4 PER STANDARD BLM INSTRUCTIONS. E-W FN IS SOUTH 229'±.

14 ESTAB NE COR OF SE 1/4 -SE 1/4 PER STANDARD BLM INSTRUCTIONS. SET CORNER FLUSH (IN FIELD) WITH SQ POST ALONG SIDE. N-S CROOKED 1-ST BARBED ELECT. FN IS WEST 33'. SAME TYPE OF FN E'LY IS 174'±S.

C. Description of monument for corner and accessories established to perpetuate locating the position of the corner:

I-4

I-5

13

FD DEPT MON 1'± DEEP IN CTR  
E-W GRAVEL RD.

25" MAPLE S40°W 47.33

22" MAPLE N54°W 60.09

7" OAK N12°W 106.28

SET CED POST

W/LOC TAG. NORTH 33'

FD SQ WOOD POST & DROVE 1" X  
6' PIPE W/DNR CAP & 3'(X) ARM  
& 7' STEEL FN POST.

N'LY EDGE TAG ALDER SWP-

N. 800'±40'

DROVE 5/8" X 34" REROD W/RLS  
CAP & SET CED POST W/LOC TAG.

30" W PINE N15°E 43.9'

24" MAPLE S35°E 30.2'

19" SCOTCH


PINE S35°W 83.4'

NO OTHER WIT AVAILABLE.

Signed by Carl F. Roser 05-06-86

Date

Surveyor's Michigan License No. 12028

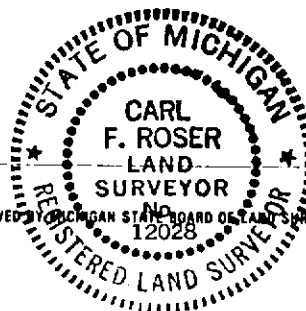

FORM APPROVED BY MICHIGAN STATE BOARD OF LAND SURVEYORS, JAN. 28, 1971  
 REVISED MAY 14, 1975  
 REVISED JAN., 1983