

**LAND CORNER RECORDATION CERTIFICATE**  
**Filing Requirement of Act 74, Mich. P.A. 1970**

For corners in

# 1214

Missaukee County Located In: Corner Code #  
 (County)

1. Public Land Survey T 23N R 6W M-5  
 T R  
 T R  
 T R  
 T R

2. Property Controlling S T R  
 in Section S T R  
 3. Miscellaneous S T R  
 Property in Sec. S T R

LIBER 315 PAGE 1117

MISSAUKEE COUNTY MICHIGAN  
 RECORDED DEC 29 1997 1:55 P.M.  
*Paulyn Klare*  
 REGISTER  
 Register of Deeds Stamp & File  
 Number

4. Lot No. \_\_\_\_\_, Recorded Plat \_\_\_\_\_  
 5. Private Claims \_\_\_\_\_

	A	B	C	D	E	F	G	H	I	J	K	L	M
1													
2	6		5		4		3		2		1		
3													
4	7		8		9		10		11		12		
5													
6	18		17		16		15		14		13		
7													
8	19		20		21		22		23		24		
9													
10	30		29		28		27		26		25		
11													
12	31		32		33		34		35		36		
13													

I, Daniel E. Schripsema, in a field survey on October 1, 1997 do hereby state that under requirements of P.A. 74, Michigan P.A. of 1970, the corner points mentioned in lines 1 and 2 above were in conformance with regulations and rules therefore as required in the current manual of survey instructions of the United States Department of the Interior, Bureau of Land Management or by a decree of a Court of Law and /or that the corner points mentioned in lines 3, 4 and 5 above were in conformance with the rules of the Michigan Board of Land Surveyors or by a Decree of a Court of Law; established, re-established, monumented, recovered, found as expressed below:

NOTE: Not more than 2 corners, all in the same town and range, may be recorded on this certificate

A. Description of original monument and accessories and/or subsequent restoration:

- M-5) 1839 GLO survey set post corner sections 12, 13; Birch 12 S35W 7, Hemlock 12 N05W 20
- 1913 Iron stake, county surveyor records
- 1985 Robert F. Mitchell LCRC, #700; Fd. 1" Iron, raised w/ 1/2" rerod and cap  
 N30W 6" Scotch Pine 56.04', N55W Cor. Fence Post 39.37', South 1/4" Bolt Spike 6.80',  
 On centerline roads. N-S & E
- 1992 Carl F. Roser LCRC, #866; Fd. 1/2" rerod w/ cap  
 Cor FN Post N50W 47.06', 7" Scotch Pine N35W 56.06', Cor FN Post S50E 39.47', Carriage Bolt S05W 6.85'

B. Description of corner evidence found and/or method applied in restoring or reestablishing corner:

- M-5) Corner common to Sections 12 & 13, T23N, R6W and Sections 7 & 18, T23N, R5W. Found 1/2" rerod/ cap over 1" iron.  
 Corner falls in centerline of intersection of roads North, South and East.

This corner is accepted as a careful and faithful perpetuation of the position of the original corner

C. Description of monument for corner and accessories established to perpetuate locating the position of the corner


- M-5) Set Missaukee County Monument on existing 1/2" rerod.

- S43E 39.69' Corner fence post
- N52W 47.07' Corner fence post
- N37W 56.03' 10" Scotch pine
- N55E 42.01' plot at phone riser
- S05W 6.85' carriage bolt

Peer Group Reviewed and Approved  
 Date: 12-15-97  
*J. Dean Geers*  
 J. Dean Geers, Missaukee Co. Representative

Signed by Daniel E. Schripsema  
 Surveyor's Michigan License No. 24617

Date 12-2-97

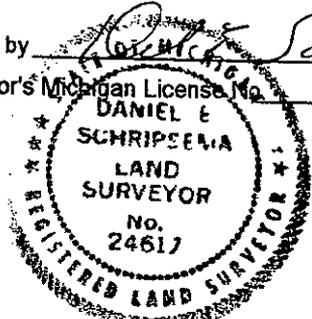

**SURVEY & REMONUMENTATION**

**JAN 16 1998**

**SECTION**