

LAND CORNER RECORDATION CERTIFICATE Filing Requirement of Act 74, Mich. P.A. 1970

For corners in

Missaukee
(County)

Located In:

Corner Code #

1. Public Land Survey	T 23N R 6W	M-10
	T R	
	T R	
	T R	
2. Property Controlling in Section	S T R	
	S T R	
3. Miscellaneous Property in Sec.	S T R	
	S T R	

4. Lot No. , Recorded Plat

5. Private Claims

#1218

LIBER 315 PAGE 1121

MISSAUKEE COUNTY MICHIGAN

RECORDED DEC 29 1997 1:25 PM

Register of Deeds Stamp & File Number

I, Daniel E. Schripsema, in a field survey on October 1, 19 97 do hereby state that under requirements of P.A. 74, Michigan P.A. of 1970, the corner points mentioned in lines 1 and 2 above were in conformance with regulations and rules therefore as required in the current manual of survey instructions of the United States Department of the Interior, Bureau of Land Management or by a decree of a Court of Law and for that the corner points mentioned in lines 3, 4 and 5 above were in conformance with the rules of the Michigan Board of Land Surveyors or by a Decree of a Court of Law; established, re-established, monumented, recovered, found as expressed below:

NOTE: Not more than 2 corners, all in the same town and range, may be recorded on this certificate

	A	B	C	D	E	F	G	H	I	J	K	L	M
1													
2	6			5		4		3		2		1	
3													
4	7			6		9		10		11		12	
5													
6	18			17		16		15		14		13	
7													
8	19			20		21		22		23		24	
9													
10	30			29		28		27		26		25	
11													
12	31			32		33		34		35		36	
13													

A. Description of original monument and accessories and/or subsequent restoration:

M-10) 1839 GLO survey set quarter post section 25; Hemlock 11 S57W 16, do 10 N38W 14
1976 Frederick H Thomson LCRC, # 204; Fd. 1/2" iron rod
1976 Frederick H Thomson survey, Liber S-1, pg. 295; Fd. 1/2" iron rod
SW CF Post 0.5', NE Old RR Grade 60', No trees nearby
1977 Frederick H Thomson survey Liber S-1, pg. 341; same as rec. Liber S-1, pg. 295
1978 Frederick H Thomson survey Liber S-1, pg. 440 same as Liber S-1, pg. 295
1978 Frederick H Thomson survey Liber S-1, pg. 442 same as Liber S-1, pg. 295

B. Description of corner evidence found and/or method applied in restoring or reestablishing corner:

M-10) Corner common to Section 25, T23N, R6W and Section 30, T23N, R5W. Found 1/2" iron of record.
Corner falls next to corner fence post with fence N,S,E, & W.

This corner is accepted as a careful and faithful perpetuation of the position of the original corner.

C. Description of monument for corner and accessories established to perpetuate locating the position of the corner:

M-10) Set Missaukee County Monument on existing iron
S41W 1.08' Corner fence post
N33W 127.49' 10" Poplar
S11W 58.96' 8" Poplar
S65W 81.42' 8" Poplar
North 77' RR Grade
N66E 73' RR Grade
N54W 115.06' pine stump


Peer Group Reviewed and Approved

Date: 12-13-97
J. Dean Geers, Missaukee Co. Representative

Signed by Daniel E. Schripsema

Date 12-2-97

Surveyor's Michigan License No. 24617

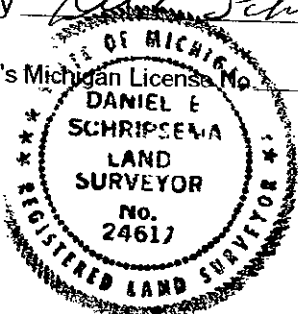

FORM APPROVED BY MICHIGAN STATE BOARD OF PROFESSIONAL SURVEYORS, JAN. 28, 1971
REVISED MAY 14, 1975
REVISED JAN., 1983
REVISED OCT., 1995

SURVEY &
REMONUMENTATION

JAN 16 1998

SECTION