

Land Corner Recordation Certificate
Authority: 1970 PA 74, MCL 54.205


Surveyor's Name: Craig W. McVean
Field Survey Date: Aug. 31, 2017
For corner(s) in: Missaukee County

Original Public Land Survey Corner
S T R
S T R
S T R
S T R

Property Controlling Corner
S T R
S T R
S T R
S T R

Property Corner
S 22 T 23N R 7W 2
S 23 T 23N R 7W 8
S T R
S T R

Protracted Public Land Survey Corner
S T R
S T R
S T R
S T R

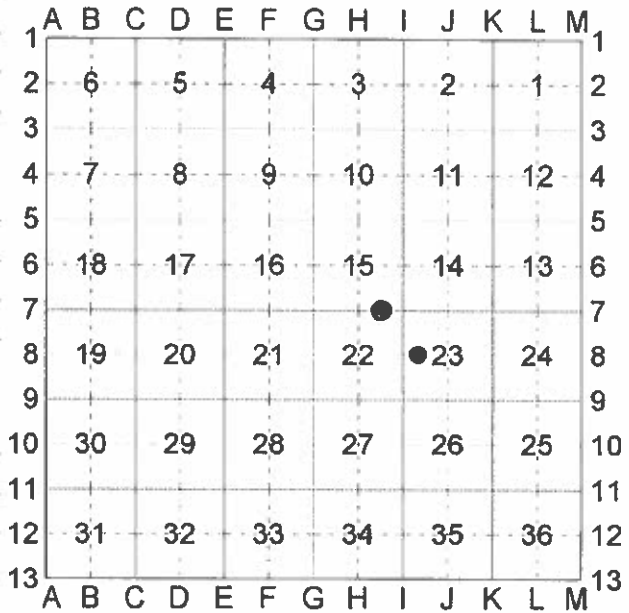

Part A: Corner History

2 - E 1/16 Corner common to Sec. 15 & 22, T23N, R7W
- None
8 - CW 1/16 Corner Sec. 23, T23N, R7W
- None

Part B: Surveyor's Report on Perpetuation, Restoration, Reestablishment, or Monumentation of Corner

2 – E 1/16 Corner common to Sec. 15 & 22, T23N, R7W.

- Set 2" Alum. Cap on 5/8" x 34" long iron rebar per Standard BLM procedure.
- Corner in cedar swamp.

8 – CW 1/16 Corner Sec. 23, T23N, R7W

- Set 2" Alum. Cap on 5/8" x 34" long iron rebar per Standard BLM procedure.
- Corner in E-W single strand fence. Corner of Fence N & W is 15.3' East.

Part C: Field Evidence of Perpetuation or Monumentation of Corner

2 – E 1/16 Corner common to Sec. 15 & 22, T23N, R7W.

Stamped 2" Aluminum Cap on 5/8" x 34" long iron rebar.

Set Blue Composite Post with Loc. Tag 1' SW.

S82°W 4.34' to set N & T in N. side 13" Cedar

N63°E 15.16' to set N & T in N. side 4" R. Maple

S25°E 10.62' to set N & T in W. side 10" Cedar

S41°W 21.92' to set N & T in SE side 10" Cedar

8 – CW 1/16 Corner Sec. 23, T23N, R7W.

Set Blue Composite Post with Loc. Tag 1' SW

N19°W 24.53' to set N & T in NW side 7" W. Pine

S75°E 13.37' to set N & T in S side 22" R. Pine

S28°W 23.36' to set N & T in SE side 10" R. Pine

S41°W 37.88' to set N & T in SE side 20" R. Pine



Craig W. McVean

Craig W. McVean

11/21/2017

Date

Professional Surveyor's License No.: 39088

Prepared By:

Craig W. McVean

Michigan Dept. of Natural Resources

8015 Mackinaw Trail

Cadillac, Michigan 49601

Land Corner Recordation Certificate

S 22 T 23N R 7W Code 2

S 23 T 23N R 7W Code 8

Page 2 of 2