

SURVEY &
REMONUMENTATION

LIBER 291 PAGE 448

APR 24 1995

LAND CORNER RECORDATION CERTIFICATE
Filing Requirement of Act 74, Mich. P.A. 1970

991

For corners in **COMMISSION**

Missaukee Located In: Corner Code ##
(County)

1. Public Land Survey	<u>23N</u> <u>7W</u>	<u>C-13</u>
	T <u> </u> R <u> </u>	<u> </u>
	T <u> </u> R <u> </u>	<u> </u>
	T <u> </u> R <u> </u>	<u> </u>
	T <u> </u> R <u> </u>	<u> </u>
2. Property Controlling	S <u> </u> T <u> </u> R <u> </u>	<u> </u>
in Section	S <u> </u> T <u> </u> R <u> </u>	<u> </u>
3. Miscellaneous	S <u> </u> T <u> </u> R <u> </u>	<u> </u>
Property in Sec.	S <u> </u> T <u> </u> R <u> </u>	<u> </u>

MISSAUKEE COUNTY MICHIGAN

RECORDED JAN 23 1995 12:01 PM

Paulyn Flore
REGISTER

Register of Deeds Stamp & File Number

4. Lot No. _____, Recorded Plat _____
5. Private Claims _____

I, Daniel E. Schripsema a field survey on December, 19 94,
do hereby certify that under requirements of P.A. 74, Michigan P.A. of 1970, the corner points mentioned
in lines 1 and 2 above were in conformance with regulations and rules therefore as required in the
current manual of survey instructions of the United States Department of the Interior, Bureau of Land
Management or by a decree of a Court of Law and/or that the corner points mentioned in lines 3, 4 and 5
above were in conformance with the rules of the Michigan Board of Land Surveyors or by a Decree of a
Court of Law; established, re-established, monumented, re-monumented, recovered, found as
expressed below:

NOTE: Not more than 4 corners, all in the same town and range, may be recorded
on this certificate.

A. Description of original monument and accessories and/or subsequent restoration:

- C-13) 1836 GLO post by John Brink, Deputy Surveyor
Hemlock 8 N 44 W 13,
Hemlock 10 N 12 1/2 E 64
C-13) 1909 J.S. Cavanagh, County Surveyor
Stake
N about 65 W, 51 Tel. Pole
NE, 37 Fence Post
Cont' on Back

B. Description of corner evidence found and/or method applied in restoring or reestablishing corner:

- C-13) Section corner common to Sections 31 and 32

Found 1 1/8" bar per Liber 1, page 243 and is accepted
as a careful and faithful perpetuation of the position
of the original corner. Corner is located 3.5' North
of the centerline of the East-West road and in the
centerline of the North-South road.

C. Description of monument for corner and accessories established to perpetuate locating the position of the corner:

- C-13) Set 1 1/2" Pipe with 2 1/2" brass Missaukee County
monument over the existing Iron in monument box.


S 30 E-75.02'-Fence Post
S 22 E-78.69'-Top of Conc. R.O.W. Marker
S 20 W-78.64'-Top of Conc. R.O.W. Marker
N 26 W-66.43'-P.Pole

Peer Group Reviewed and Approved

Date: 11-2-94

J. Dean Geers
J. Dean Geers, Missaukee Co. Representative

Signed by D. E. Schripsema
Surveyor's Michigan License No. 24617

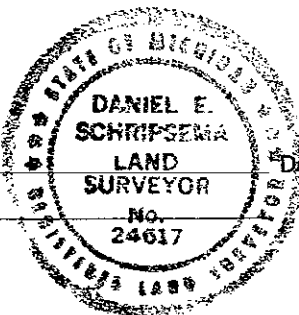

Date 12-30-94