

APR 24 1995

LIBER 291 PAGE 438

984

COMMISSION

LAND CORNER RECORDATION CERTIFICATE
Filing Requirement of Act 74, Mich. P.A. 1970

For corners in

<u>Missaukee</u> (County)	Located In:	Corner Code #
1. Public Land Survey	T <u>23N</u> R <u>7W</u>	<u>J-13</u>
	T _____ R _____	_____
	T _____ R _____	_____
	T _____ R _____	_____
2. Property Controlling in Section	S _____ T _____ R _____	_____
	S _____ T _____ R _____	_____
3. Miscellaneous Property in Sec.	S _____ T _____ R _____	_____
	S _____ T _____ R _____	_____
4. Lot No. _____, Recorded Plat _____		
5. Private Claims _____		

MISSAUKEE COUNTY MICHIGAN

RECORDED JAN 23 1995 12:01 PM

Paulyn Flare
Register of Deeds Stamp & File Number

I, Daniel E. Schripsema, in a field survey on December, 19 94, do hereby certify that under requirements of P.A. 74, Michigan P.A. of 1970, the corner points mentioned in lines 1 and 2 above were in conformance with regulations and rules therefore as required in the current manual of survey instructions of the United States Department of the Interior, Bureau of Land Management or by a decree of a Court of Law and/or that the corner points mentioned in lines 3, 4 and 5 above were in conformance with the rules of the Michigan Board of Land Surveyors or by a Decree of a Court of Law; established, re-established, monumented, re-monumented, recovered, found as expressed below:

A	B	C	D	E	F	G	H	I	J	K	L	M
2	6	5	4	3	2	1						
3												
4	7	8	9	10	11	12						
5												
6	18	17	16	15	14	13						
7												
8	19	20	21	22	23	24						
9												
10	30	29	28	27	26	25						
11												
12	31	32	33	34	35	36						
13												

NOTE: Not more than 4 corners, all in the same town and range, may be recorded on this certificate.


- A. Description of original monument and accessories and/or subsequent restoration:
- J-13) 1836 GLO Quarter Section Post by John Brink, Deputy Surveyor
Beech 7 N79E 17
Beech 10 N75W 47
 - J-13) 1890 & 1891 Richardson Field Book 14, no comment.
 - J-13) 1988 Wilcox Associates, LCRC Recorded Liber S-1, Page 779.
Found 1/2" Iron
 - J-13) 1988 Wilcox Associates, Survey Rec. Liber S-2, Page 418.
 - J-13) 1992 Wilcox Associates, Survey Rec. Liber S-3, Page 121.

- B. Description of corner evidence found and/or method applied in restoring or reestablishing corner:
- J-13) Found 1/2" capped iron per 1988 LCRC and accepted as a careful and faithful reestablishment of the position of the original corner.

- C. Description of monument for corner and accessories established to perpetuate locating the position of the corner:
- J-13) Replace existing 1/2" iron with 5/8" iron with 2 1/2" brass Missaukee County monument and installed monument box.
N 56 W 99.30 Tel. Pole
N 04 E 53.12 5" Spruce
N 52 E 67.30 Tel. Pole
S 51 E 92.05 12" Maple in Clump

Peer Group Reviewed and Approved
Date: 12-21-94
J. Dean Geers
J. Dean Geers, Missaukee Co. Representative

Signed by D. E. Schripsema
Surveyor's Michigan License No. 24617

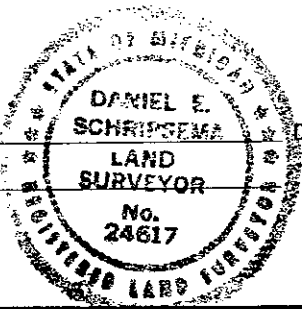

Date 12-30-94