

SURVEY & REMONUMENTATION

JAN 27 1999

LIBER 324 PAGE 1292

SECTION

LAND CORNER RECORDATION CERTIFICATE Filing Requirement of Act 74, Mich. P.A. 1970

1312

For corners in

Missaukee
(County)

Located In:

Corner Code #

1. Public Land Survey

T ²³N R ⁸W
T R
T R
T R

K-13

2. Property Controlling
in Section

S T R
S T R

3. Miscellaneous
Property in Sec.

S T R
S T R

MISSAUKEE COUNTY MICHIGAN

RECORDED DEC 28 1998 1 P.M.

Caryn Flare
REGISTER

Register of Deeds Stamp & File Number

4. Lot No. _____, Recorded Plat _____
5. Private Claims _____

I, Phillip D. Case, in a field survey on August 18, 19 98 do hereby state that under requirements of P.A. 74, Michigan P.A. of 1970, the corner points mentioned in lines 1 and 2 above were in conformance with regulations and rules therefore as required in the current manual of survey instructions of the United States Department of the Interior, Bureau of Land Management or by a decree of a Court of Law and/or that the corner points mentioned in lines 3, 4 and 5 above were in conformance with the rules of the Michigan Board of Land Surveyors or by a Decree of a Court of Law; established, re-established, monumented, recovered, found as expressed below:

NOTE: Not more than 2 corners, all in the same town and range, may be recorded on this certificate.

	A	B	C	D	E	F	G	H	I	J	K	L	M
1													
2	6		5		4		3		2		1		
3													
4	7		8		9		10		11		12		
5													
6	18		17		16		15		14		13		
7													
8	19		20		21		22		23		24		
9													
10	30		29		28		27		26		25		
11													
12	31		32		33		34		35		36		
13													

A. Description of original monument and accessories and/or subsequent restoration:

K-13 Corner common to Section 35 and 36, T23N, R8W and Section 1 and 2, T22N, R8W: Post set in lake in the original government survey by Deputy Surveyor Brink in May of 1838: No corner witnessed taken.

Schweigert and Young in their November 1, 1962 survey for Missaukee Lakes Land Company set a concrete monument on line between the South One-quarter corner of Section 34 and the meander post on the Township line at the East edge of Lake Missaukee by single proportionate measurement.

Corner witnessed by:
S19°W - 20" White Pine - 101.6'
N66°30'E - 4" Jack Pine - 61.3'

B. Description of corner evidence found and/or method applied in restoring or reestablishing corner:

K-13 Found concrete monument and one of Young's 1963 witnesses of record. Corner falls in a swamp and of this date is 1.5' under the water.

Peer Group Reviewed and Approved

Date: 10-26-98

J. Dean Geers
J. Dean Geers, Missaukee Co. Representative


Topped monument with a brass cap and is accepted as a careful and faithful reestablishment of the position of the original corner.

C. Description of monument for corner and accessories established to perpetuate locating the position of the corner:

K-13

Set Missaukee County Brass Cap on top of found concrete monument

N72°E - 6" stump with blaze - 61.2' (old wit.)
N78°W - 8" White Pine - 56.76'
N70°E - 5" Jack Pine - 100.60'
S25°W - 36" White Pine - 101.94'
N06°E - 10" White Pine - 187.21'

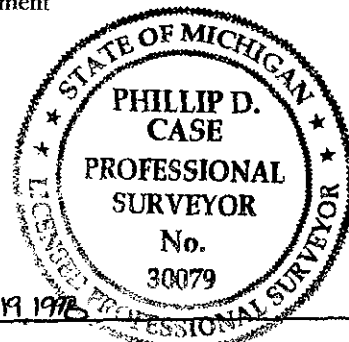

Signed by Phillip D. Case
Surveyor's Michigan License No. 30079

Date NOVEMBER 19 1998