


STATE OF MICHIGAN
DEPARTMENT
OF
NATURAL RESOURCES

LAND CORNER RECORD

MISSAUKIE COUNTY
T 24 N R 6 W

DESCRIPTION OF CORNER N 1/4 Corner of Sec. 12
(Comp. Point Only)
CORNER MONUMENT 1/4 corner inaccessible (in flooded area)
DATE MONUMENT PLACED AND WITNESSED Witness corner on N. Line of Sec. 12, Set 1"x36" pipe.
WITNESSES TO CORNER..... Witness corners 8-12-71

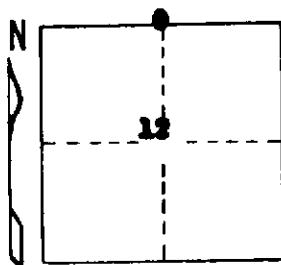


10" W. Pine N 48 E 23.4'
10" W. Pine S 07 E 24.7'
3" W. Pine N 88 W 14.2'
AND
Comp. N 1/4 Cor. Sec. 12 S89°32'30"W 487.9'

CIRCLE CORNER REGISTERED

DESCRIPTION IN DETAIL AS TO HOW CORNER WAS LOCATED AND IDENTIFIED OR RESTORED.

Witness corner on N. line of Sec. 12, Set 1"x36" pipe.
3" B. Cherry S 48 E 9.6'
3" W. Pine N 84 E 16.4'
3" W. Pine N 24 E 23.0'
Comp. N 1/4 corner Sec. 12 N 89°32'30"E 242.6'
Water Edge (Impoundment) East 75'

Corner reestablished (by computation - no corner set) per Standard B.L.M. instructions.

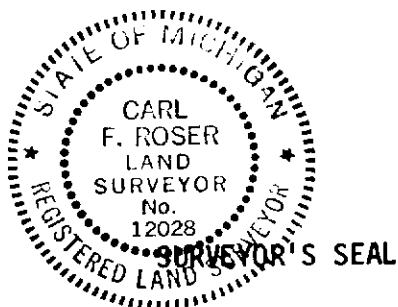

SIGNED Carl F. Roser DATE 8-19-71
REGISTERED LAND SURVEYOR 12028

DISTRIBUTION:

County Courthouse
Area Forester (Regions I & II)
District or Region Surveyor
Forestry Div., Lansing

R 4047
Rev. 10/68