



LAND CORNER RECORD

DESCRIPTION OF CORNER West 1/16 Cor on N. line of Sec. 12
(Comp. Point Only)
CORNER MONUMENT 1/16 Cor. inaccessible (in flooded area)
Wit. Cor. on N. line of Sec. 12, Set 1" x 30" Pipe
DATE MONUMENT PLACED AND WITNESSED Witness Corners 8-12-71
WITNESSES TO CORNER... Comp. 1/16 Cor N line of Sec. 12 N89°32'30"E 265.1'

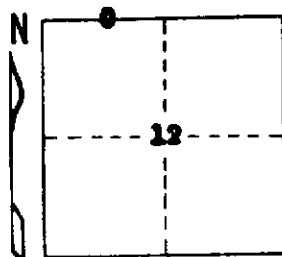

14" B. Cherry	S 81 E	13.62'
10" Maple	S 60 W	35.39'
14" Oak	N 70 W	20.04'
Ctr. Trail Rd (R.R.Gr.) West		30'
AND		
Water Edge (Impoundment) East		31'

Witness Corner on N. Line Sec. 12, Set 1"x36" pipe

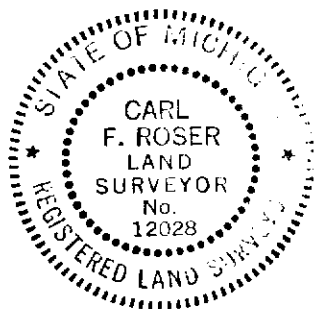

Comp.	1/16 Cor N line of Sec. 12	S 89° 32' 30" W	280.2'
	"		
	24" R. Pine	S 52 E	40.0'
	17" R. Pine	N 81 E	52.8'
	4" W. Pine	N 23 E	25.6'
	Water's Edge (Impoundment)	West	40'

SURVEYOR'S SEAL

SIGNED

REGISTERED LAND SURVEYOR 1202

DATE _____

0-19-71

DISTRIBUTION:

R 4047
Rev. 10/68