


STATE OF MICHIGAN
DEPARTMENT
OF
NATURAL RESOURCES

LAND CORNER RECORD

MISSAUKIE COUNTY
T 24 N R 6 W

DESCRIPTION OF CORNER NE corner, Section 9
CORNER MONUMENT Set Std. Dept. Mon.
DATE MONUMENT PLACED AND WITNESSED 12-4-70
WITNESSES TO CORNER..... Set Std. Dept. Mon.

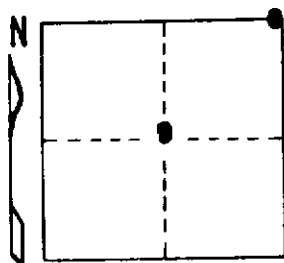


9" Oak N 17 E 34.0'
12" Oak N 30 W 14.2'
AND
N-S Random Due W 8'

CIRCLE CORNER REGISTERED

DESCRIPTION IN DETAIL AS TO HOW CORNER WAS LOCATED AND IDENTIFIED OR RESTORED.

Restored this corner from two U.S.D.Ts (w.P. stamps) SE & NW and 1900 survey witnesses NE & SW of record in Old County Surveyors book at Co. Rd.Comm.

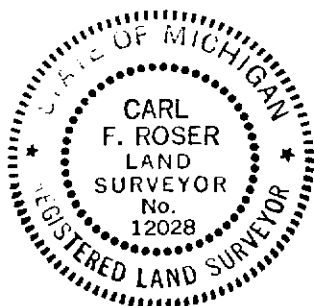

SURVEYOR'S SEAL

SIGNED Carl F. Roser DATE 12-11-70
REGISTERED LAND SURVEYOR 12028

DISTRIBUTION:

County Courthouse
Area Forester (Regions I & II)
District or Region Surveyor
Forestry Div., Lansing

R 4047
Rev. 10/68