

LAND CORNER RECORDATION CERTIFICATE  
Filing Requirement of Act 74, Mich. P.A. 1970

For corners in  
MISSAUKEE  
(County)

Located In:

Corner Code 44

1. Public Land Survey

T 24N R 6W

B-11, H-11

T        R       

I-11, I-12

T        R       

T        R       

2. Property Controlling  
in Section

S        T        R       

S        T        R       

3. Miscellaneous  
Property in Sec.

S        T        R       

S        T        R       

Register of Deeds Stamp & File Number

4. Lot No.       , Recorded Plat       

5. Private Claims       

I, CARL F. ROSER, in a field survey on SEPTEMBER 26, 19 89, do hereby certify that under requirements of P.A. 74, Michigan P.A. of 1970, the corner points mentioned in lines 1 and 2 above were in conformance with regulations and rules therefore as required in the current manual of survey instructions of the United States Department of the Interior, Bureau of Land Management or by a decree of a Court of Law and/or that the corner points mentioned in lines 3, 4 and 5 above were in conformance with the rules of the Michigan Board of Land Surveyors or by a Decree of a Court of Law; established, re-established, monumented, re-monumented, recovered, found as expressed below:

NOTE: Not more than 4 corners, all in the same town and range, may be recorded on this certificate.

A. Description of original monument and accessories and/or subsequent restoration:

B-11

H-11


I-11

(\*B\* CONTINUED)

2' X 4' X 3' HOLE AND DID NOT  
FIND ANY POST; AT ONE FOOT  
DEPTH, FD E-W BARB WIRE  
REMAINS, STAPLES & NAILS, AND  
PIECE OF CROCKERY.

I-12

	A	B	C	D	E	F	G	H	I	J	K	L	M
2	6	5	4	3	2	1							
3													
4	7	8	9	10	11	12							
5													
6	18	17	16	15	14	13							
7													
8	19	20	21	22	23	24							
9													
10	30	29	28	27	26	25							
11													
12	31	32	33	34	35	36							
13													

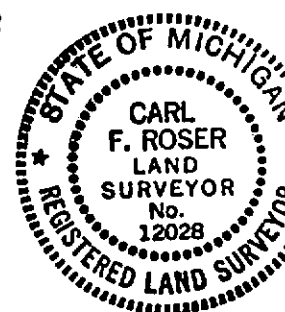

B. Description of corner evidence found and/or method applied in restoring or reestablishing corner:

B-11

H-11

I-11

I-12

FD 1/2" REROD IN RD INTERSEC  
FOR NW COR OF SEC 34. L.S.,  
J. WILCOX 1974 COR RECORD  
SAYS "FOUND 4" METAL DISK IN  
RD INTERSECTION." THREE FD  
J.W. WITS FIT FOUND 1/2"  
REROD.

RESTORED 1/4 COR TO SEC'S 27 &  
34 ON LINE OF E-W FN, (B-W ON  
CED POSTS-ALL DOWN; IN FIELD  
BERM) TO EAST, & ON AVG LINE  
OF ROW FN TIES TO NORTH 1  
MILE. THIS FITS 1914 E.A.  
BEUTHIEN SEC SUB'N OF SEC 27  
INCL FN TIES & HIS DISTANCES  
NORTH ON 1/4 LINE ROAD 1 MILE.  
(SEE FIELD NOTES & WORKING  
DNG.) ALTHOUGH WE EXCAVATED  
(CONTINUED IN "A")

DROVE IR FOR NW COR SEC 35 AT  
POSITION OF 2 FOUND POINTED  
POST BOTTOMS THAT FITS 2 OLD  
WITS (BELIEVED TO BE CD SUR  
E.A. BEUTHIEN WITS); ELM STP  
S10°E, 12.4' ± 0.5' & ELM STP  
S65°W, 24.2' ± 0.5'. OLD WITS  
WERE: ELM S67°W, 23.4' AND 7"  
ELM S07°E, 12.5'. EAST EDGE OF  
SWAMP IS 55' ± 15' W.

REESTABLISHED W 1/4 COR OF SEC  
35 FROM 2 FOUND E.A. BEUTHIEN  
1891 & 1909 WITS; 24" W PINE  
S85°E, 29.0'-FD STUMP; 30" W  
PINE WIS 1/4E, 9.2'-FD STUMP  
REMAINS. COR IS IN OLD E-W  
B-WIRE FN REMAINS (±1').

C. Description of monument for corner and accessories established to perpetuate locating the position of the corner:

B-11

H-11

I-11

I-12

FD 1/2" REROD.  
#28" MAPLE N55°E 55.09'  
6" TRPL ELM S25°W 63.50'  
GUY POLE S45°W 61.88'  
17" MAPLE N35°E 57.63'

SET STD DEPT MON (0.8'DEEP) IN  
APPROX "T" RD INTERSEC. N-S-W.  
18" R PINE N75°W 121.42'  
16" R PINE N52°W 84.95'  
18" R PINE N18°W 142.27'  
P POLE W/ TELE  
RISER N30°E 74.51'  
CTR DIRT & GR RD  
(W-N; IN CURVE N45°W 58' ±)

DROVE 1" X 8" GALV PIPE W/ALUM  
DNR CAP & DROVE 4" X 7" TREATED  
PINE POST.  
8" CEDAR N55°E 11.6'  
7" CEDAR N67°E 19.3'  
5" CEDAR S50°E 49.8'  
10" CEDAR S10°W 34.4'

SET DNR MON & CED POST.  
3" BALSAM N45°W 19.4'  
28" OLD W PNE STP N40°W 27.4'  
8" W BIRCH IN E SIDE  
OLD 42" ± W PINE  
STP REMAINS N20°E 10.4'  
3" & 6" MAPLE N85°E 21.0'  
4" BALSAM S10°W 2.5'

ARLS J. WILCOX WIT.

Signed by Carl F. Roser 12028

Date 8-10-92

Surveyor's Michigan License No.