

MICHIGAN  
DEPARTMENT OF CONSERVATION  
FORESTRY DIVISION

LAND CORNER RECORD

T. 24 N.R. 7 W


Missaukee COUNTY

DESCRIPTION OF CORNER 1/4 Corner common to Sections 9-16

CORNER MONUMENT Set 1" pipe with 1/4" Aluminum Cap

DATE MONUMENT PLACED AND WITNESSED June 14, 1966

WITNESSES TO CORNER.....

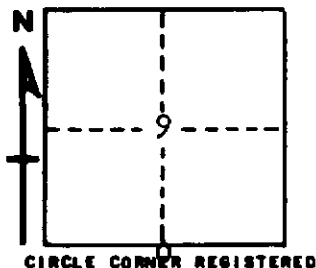

5" R. Pine S 55 E 57.1'

20" R. Pine S 35 W 35.9'

AND

Concrete-pipe monu. S 39 E 28.6'

DESCRIPTION IN DETAIL AS TO HOW CORNER WAS LOCATED AND IDENTIFIED OR RESTORED.

This corner was set by proportionate measurement, midpoint on line, between section corners while making a survey in this township. Found a pipe-monument in place about 29' SE of proper position for corner. Could find no evidence of USBTs, and no apparent reason for placing the corner so far from line and midpoint.

SURVEYOR'S SEAL

SIGNED Kenneth J. Osting DATE June 14, 1966  
REGISTERED LAND SURVEYOR #10068