Land Corner Recordation Certificate Attachment B to 2018 Annual Grant Agreement


Authority: MCL 54.205 and R54.202

This form is **ONLY** for corners filed under the 2018 State Survey and Remonumentation Grant Agreement

Filing Requirement: MCL 54.268(2)(a), 54.268(2)(d), 54.201 – 54.210d and 2018 State Survey and Remonumentation Grant Agreement

Notes:

- No more than two Original Public Land Survey Corners can be recorded on this certificate
- If a corner reported hereon is common to two or more survey townships, each Town, Range and Corner Code for the corner may be identified on this certificate
- If a corner reported hereon is common to two or more counties, each county may be identified on this certificate and a copy of this certificate filed with the Register of Deeds in each county

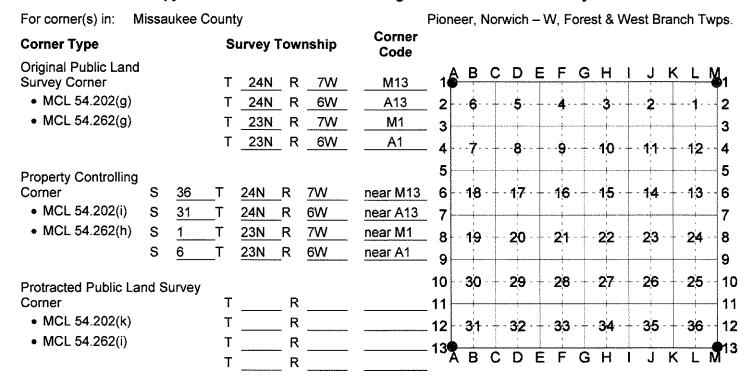

Part A: Corner(s) History

M13-A13-M1-A1 — Township corner common to Sec. 36, T24N, R7W, Sec. 31, T24N, R6W; Sec. 1, T23N, R7W and Sec. 6, T23N, R6W

- 1838 GLO Set post J. Brink; 1) Beech 8" N67°W 41 L.; 2) Beech 16" S52°E 15 L.
- 1874 B. C. Bonnell Sec. 31 (24-6) Survey 39.75 to 'A12'
- 1889 CSR FB #14, p. 61 & Teed FB #125, p. 54 Perpetuated. Drove a Hemlock stake 2 feet long 4 ½" in diameter level with the surface and placing broken china around stake.
- 1892 CSR FB #14, p. 62 Sec. 1 (23-7) survey. See page 61 'G'. 39.55 to 'L1', 35.52 to 'M2'.
- **1895** CSR FB #15, p. 60 Hemlock Stake 2 ft. long 4 ½" in diameter level with surface. Placing broken china around.
- 1909 CSR Pioneer FB, p. 46-49 J. G. Cavanagh Remonumentation of Township. Planted gas pipe set in concrete. 3) Sugar 6" N37 % E 81; 4) Beech 6" N35½°W 69½; 5) Sugar 20" S35½°W 30
- 1911 CSR FB #14, p. 77 Sec. 1 (23-7) Survey E. A. Beuthien 'A' see Pioneer. 40.14 to 'L1'; 35.92 to 'M2'.
- No Date FB #35, p. 47 [combination of 1892 & 1909 Data] stake, stone & cement block. 1909 Wits repeated.
- No Date CSR FB #14 (23-7) p. 43, and FB #32 (24-6), p. 32 1909 Wits repeated.
- **1972** Record Survey L. 1, p. 24 to 27 L. L. Cavanagh (PS # 17614) Set ½" x 18" steel rod; 6) Power pole N60°E 43.14'; 4) 22" Beech N40°W 43.0'
- 1972 Rec. Survey L. 1, p. 28 L. Cavanagh 1/2" x 18" Bar

Land Corner Recordation Certificate
Attachment B to 2018 Annual Grant Agreement
T 24N R 7W Code M13
T 24N R 6W Code A13
T 24N R 7W Code M1
T 24N R 6W Code M1
T 24N R 6W Code A1
T 24-23N, R 7-6W Code PCC near M13-A13-M1-A1
Page 2 of 3

Part A (Continued): Corner(s) History

- 1980 DNR working drawing & field notes Fd. ½" rerod. Also found Cavanagh mon. 1'+ deep and pieces of broken crockery. Raised w/ 5/8" rerod. 2.30' E & 0.45'± 0.02' S (2.35' diagonal) from ½" rebar. Removed J. G. Cavanagh monument. C. F. Roser Note: "Accepted Larry Cavanagh (RLS #17614) Cert. of Survey for South line of Sec. 36, T24N-R7W, for following reasons: (a) Larry's S¼ & SE fit fence south from position of E 1/8 Cor.; (b) Larry's SE was set from 1- 1909 J. G. C. Wit & he didn't find his actual mon. which was 0.4' S & 2.3' E; to change Larry's Survey now would up-set a lot of work not worth it; (c) Accepted Larry's S¼ Cor. for reasons (b) and also there is an old May 1911 E. A. Beuthien Sur. of Sec. 1 (23-7) that indicates the Twp. Line (N. line S-1) as being a straight line; See brown field book at Co. Rd. Comm. 1 T23N-R7W, Page 77. (also fits center E-W Road better)"
- 1981 LCRC #634 C. F. Roser (PS # 12028) Fd. and accepted ½" x 18" rod per L. Cavanagh. Larry apparently set corner from one 1909 J. G. Cavanagh wit.; 6" Beech N35½°W 45.9'. Fd. ½" x 18" rod replaced w/ 5/8" x 36" rerod w/ RLS cap. 4) 26" Beech N30°W 44.53'; 7) 6" Maple S50°W 53.68'; 8) 28" Maple S22°E 61.40'; 9) Set Cedar post w/ loc. tag N45°E 47'. Corner falls in Center E-W gravel road. Center Trail Rd. S is E 6'±.
- 1997 DNR Survey Project # FM-06-93- C. Kiiskila 1981 Dept. Cor. of record. Retracement Survey T23N, R7W.
- 1997 Remon. LCRC #1178 J. D. Geers (PS #33977) Fd. iron recorded in L. 1, p. 634 Corner in centerline E-W road. Set Missaukee Co. Monument on existing iron. 10) S45°E 47.- 3" Maple; 11) N27°W 45.97' 20" Maple; 12) N20°E 53.43' 4" Basswood; 13) S62°W 47.01' 16" Maple
- 2002 Rec. Survey L. S-4, p. 171 J. K. Autenrieth (PS # 31588) shows corner
- 2007 (1997) Rec. Survey L. S-5, p. 38 P. D. Case (PS # 30079) Fd. 5/8" bar and cap 1'± S of centerline E-W Road and 3'± West of Trail Rd. to South 8) Fd. nail in SW side 33" Maple S20°E 61.45' 14) Fd. spike in SW Cor. 4 x 4 wood post S18°E 37.03'; 13) Fd. spike N side 14" Maple S64°W 46.95'; 9) Fd. nail in SE side DNR Loc. Post N41°E 46.76'; 4) Fd. 26" Beech Stump N29°W 44.05' Center.; 15) Set nail SW side 20" Beech N04°W 59.57

Part B: Surveyor's Report on Perpetuation or Monumentation of Corner(s)

- M13-A13-M1-A1 Township corner common to Sec. 36, T24N, R7W, Sec. 31, T24N, R6W; Sec. 1, T23N, R7W & Sec. 6, T23N, R6W Reset J. G. Cavanagh position per previous ties in DNR Survey notes. Could not accept Roser's reasoning for removing this historical survey corner monument. During excavation 2.5' down found pieces of broken white china. Set stamped 2½" Brass Cap on 5/8" x 34" rebar with 4" x 10" Plastic tile with concrete around cap. Cap down 0.8'. Fits remains of witness #4. Centerline of E-W gravel road is 0.5' N. Centerline of Trail Road S. is 1.5'± East. Witnesses # 1, 2, 3 & 5 are gone; #6 through 15 are not applicable to this position. 2½" Brass Cap accepted as a careful and faithful perpetuation of the position of the original corner.
- PCC near M-13-A13-M1-A1: This position had been graded out due to lowering of road grade in this area. Reset Cabin spike per record LCRC #1178 witnesses. Spike is N78°55'W 2.35' from "M13-A13-M1-A1". This position has been used by L. Cavanagh, Roser, Kiiskila, Geers, Autenrieth, Case and possibly others. Cabin spike at L. Cavanagh position not utilized as "M13-A13-M1-A1" in this survey. This property controlling corner is recorded by this surveyor strictly to comply with the requirements of P.A. 74 of 1970 as amended and P.A. 345 of 1990 as amended and is not an endorsement of the corner position.

Part C: Field Evidence of Perpetuation or Monumentation of Corner(s)

M13-A13-M1-A1 – Township corner common to Sec. 36, T24N, R7W, Sec. 31, T24N, R6W; Sec. 1, T23N, R7W & Sec. 6, T23N, R6W – Stamped 2 ½" Brass Cap on 5/8" x 34" iron rebar with 4" x 10" long plastic tile with concrete around cap – Down 0.8'. Placed found broken china back in hole as memorial.

N35°W 46.14' to set 1/2" x 18" rebar in centerline remains 24"+ Beech stump (#4)

N30°W 47.16' to Fd. nail in W. side 35" Sugar Maple

N45°W 131.34' to SE Corner Block House

N14°E 53.11' to set nail & tag at fd. nail in W. side 10" Basswood

S80°W 48.70' to fd. nail in N. side 16" Sugar Maple

N50°E 45.75' to Fd. nail in SE side Cedar witness post

N78°55'W 2.35' to PCC near M13-A13-M1-A1

- PCC near M13-A13-M1-A1
 - Cabin spike. N27°W 45.97′ – 35″ Maple; N20°E 53.43′ – 10″ Basswood; S62°W 47.01′ – 16″ Maple; S78°55′E 2.35′ to M13-A13-M1-A1 – 2 ½″ Brass Cap.

Land Corner Recordation Certificate Attachment B to 2018 Annual Grant Agreement T<u>24N</u> R_7W_ Code M13 24N R_6W Code A13 <u>24N</u> R_7W Code M1 R_6W Code A1 24N 24-23N , R 7-6W Code PCC near M13-A13-M1-A1 Page 3 of 3

| Date of Observation | Latitude | Longitude | Datum and Adjustment Year | Epoch Date |
|------------------------|-----------------|-----------------|------------------------------|------------|
| M13-A13-M1-A1 | N44°25'23.7496" | W85°05'45.1151" | NAD83(2011) | 2010.00 |
| 06/21/2018 | | | | |

Set by conventional sideshot and distance checks from 3 GNSS Control points. Each control point has 2 GNSS Static baselines from 2 Local OPUS base stations adjusted by Least squares

PCC near M13-A13-M1-A1 N44°25′23.754" W85°05′45.147" NAD83(2011) 2010.00 05/05/2018

2 Static GNSS Baseline from 2 local OPUS base stations adjusted by Least squares

I, Craig W, McVean, in a field survey on 06/21/2018, certify under the requirements of the State Survey and Remonumentation Act, 1990 PA 345, MCL 54.261 to 54.279, and the Corner Recordation Act, 1970 PA 74, MCL 54.201 to 54.210d, that the corner(s) identified and described hereon has been perpetuated or monumented as described in Parts A, B, and C above, pursuant to the laws and rules of the State of Michigan.

| described in Parts A, B, and C above, pursuant to the law | s and rules of the State of M | ichigan. |
|--|-------------------------------|------------------------|
| Cruy W. MeVen | 12/18/2018 | ANTE OF MICHIGA |
| Craig W. McVean | Date | CRAIG W. |
| Professional Surveyor's License No.: 39088 | | PROFESSIONAL SURVEYOR |
| Michigan Dept. of Natural Resources, 8015 Mackinaw Trail, Cadillac, Michigan, 49601 | | 99088 39088 SIONAL SIN |

I, J. Dean Geers, state that the corner(s) identified and described hereon and perpetuated or monumented as described in Parts A, B, and C above was presented to and reviewed by the Peer Review Group on Dec. 11, 2018 and is accepted for filing in the Missaukee County Remonumentation Program.

| J. Dean Geers | | Date | |
|--------------------------------------|-------|------|--|
| Professional Surveyor's License No.: | 33977 | | |