

LAND CORNER RECORDATION CERTIFICATE
Filing Requirement of Act 74, Mich. P.A. 1970

For corners in

Missaukee County
(County)

Located In:

Corner Code ##

- | | | |
|---------------------------------------|--------------------------------------|-----------|
| 1. Public Land Survey | T <u>24N</u> R <u>8W</u> | E-5 |
| | T <u>24N</u> R <u>8W</u> | E-6 |
| | T _____ R _____ | |
| | T _____ R _____ | |
| 2. Property Controlling
in Section | S <u>16</u> T <u>24N</u> R <u>8W</u> | <u>15</u> |
| | S _____ T _____ R _____ | |
| 3. Miscellaneous
Property in Sec. | S _____ T _____ R _____ | |
| | S _____ T _____ R _____ | |

Register of Deeds Stamp & File Number

4. Lot No. _____, Recorded Plat _____
5. Private Claims _____

I, Carl F. Roser, in a field survey on February 6, 19 86, do hereby certify that under requirements of P.A. 74, Michigan P.A. of 1970, the corner points mentioned in lines 1 and 2 above were in conformance with regulations and rules therefore as required in the current manual of survey instructions of the United States Department of the Interior, Bureau of Land Management or by a decree of a Court of Law and/or that the corner points mentioned in lines 3, 4 and 5 above were in conformance with the rules of the Michigan Board of Land Surveyors or by a Decree of a Court of Law; established, re-established, monumented, re-monumented, recovered, found as expressed below:

NOTE: Not more than 4 corners, all in the same town and range, may be recorded on this certificate.


C. Continued

As described on original monument and accessories and/or subsequent restoration.

15

Drove 5/8" x 34" rerod w/RLS Cap &
 set cedar post w/loc tag
 6" Red Oak N10°W 15.60'
 NW Cor wood
 frame hse S88°E 73.8'
 14" Red Oak (clp) S60°W 38.02'
 Ctr E-W winding rd Due N 98'

	A	B	C	D	E	F	G	H	I	J	K	L	M
2	6	5	4	3	2	1							
3													
4	7	8	9	10	11	12							
5													
6	18	17	16	15	14	13							
7													
8	19	20	21	22	23	24							
9													
10	30	29	28	27	26	25							
11													
12	31	32	33	34	35	36							
13													

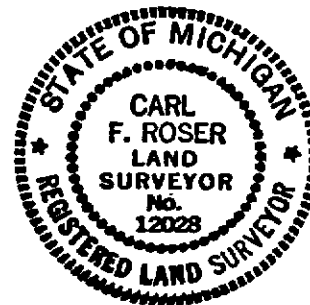

B. Description of corner evidence found and/or method applied in restoring or reestablishing corner:

E-5 - Previous Dept. (DNR) Cor. of record; KJO, Dept. RLS recovered 1912 Fargo Ir. in 1967. Fargo set Ir. from 1 U.S. Bit.

E-6 - Restored $\frac{1}{4}$ cor. of Sec. 16 on line between NW & SW corners of Sec. 16 & at 2648 feet north of SW Cor. of Sec. 16. Fits 1853 G.L.O. resurvey tie of 222 ~~acres~~ south to N. edge of Hopkins stream Rec. & Mea. & tie north of 636' to 18" White Pine line tree (now a 18"+ White Pine stp) Rec. & Mea. There is an approx. $1\frac{1}{2}$ chain (3-tally) over-run on the west line of Sec. 16 but with stream tie south & L.T. tie north this over-run definitely ~~is~~ in the N $\frac{1}{2}$ mile. Also the SW Cor. of Sec. 16 (NW Cor. Sec. 21) fits 1909 J.G. Cavanagh (Co. Sur.) Sur. of the West line of Sec. 21. Also the N.W. Cor. of Sec. 16 was recovered by Fargo Eng. in 1912 (they had one U.S. Bit.) & the DNR (Conservation Dept.) recovered Fargo's Cor. 4/17/67.

15 - Estab. SE Cor. of $\frac{1}{4}$ of $\frac{1}{4}$ of Sec. 16 mid-way & on line between fd. SW & $\frac{1}{4}$ Cor. of Sec. 16.

C. Description of monument for corner and accessories established to perpetuate locating the position of the corner:

E-5

Fd. Dept. Mon. & added cedar post
 12" Maple (clp) N15°E 90.15'
 5" Maple N50°E 57.17'
 4" Black Cherry (clp) S60°W 34.03'
 14" Maple (clp) N80°W 96.94'
 Ctr. winding trail S45°W 276'±5'

E-6

Set DNR Monument & cedar post
 7" Maple (clp) N80°E 43.3'
 17" Twin White Oak S15°E 90.9'
 6" Maple S15°W 38.7'
 5" White Pine N75°W 34.9'
 Ctr winding trail North 12'
 N'ly edge creek South 222'±

Signed by Carl F. Roser 7-23-86 Date _____

Surveyor's Michigan License No. #12028