

**SURVEY &
REMONUMENTATION**

FEB 06 1998

Montmorency County Remonumentation

Liber **00012** Page **0294**

LAND CORNER RECORDATION CERTIFICATE

Filing Requirement of Act 74, Mich. P.A. 1970

SECTION

For corners in

<u>MONTMORENCY</u> (County)	Located In:	Corner Code #
<u>ALBERT TWP.</u>		
1. Public Land Survey	T <u>29N</u> R <u>1E</u>	<u>F-11</u>
	T _____ R _____	_____
	T _____ R _____	_____
	T _____ R _____	_____
2. Property Controlling	S _____ T _____ R _____	_____
in Section	S _____ T _____ R _____	_____
3. Miscellaneous	S _____ T _____ R _____	_____
Property in Sec.	S _____ T _____ R _____	_____
4. Lot No. _____, Recorded Plat _____		
5. Private Claims _____		

STATE OF MICHIGAN
MONTMORENCY COUNTY
Recorded & Filed

12-16-1997 10:53:08

A. PANGAN-MCELROY
REGISTER OF DEEDS

Register of Deeds Stamp & File Number

I, DONALD E MARLATT, in a field survey on 6/17/, 19 97,
do hereby certify that under requirements of P.A. 74, Michigan P.A. of 1970, the corner points mentioned
in lines 1 and 2 above were in conformance with regulations and rules therefore as required in the
current manual of survey instructions of the United States Department of the Interior, Bureau of Land
Management or by a decree of a Court of Law and/or that the corner points mentioned in lines 3, 4 and 5
above were in conformance with the rules of the Michigan Board of Land Surveyors or by a Decree of a
Court of Law; established, re-established, monumented, re-monumented, recovered, found as
expressed below:

**NOTE: Not more than 4 corners, all in the same town and range, may be recorded
on this certificate.**

	A	B	C	D	E	F	G	H	I	J	K	L	M
2	6	5	4	3	2	1							
3													
4	7	8	9	10	11	12							
5													
6	18	17	16	15	14	13							
7													
8	19	20	21	22	23	24							
9													
10	30	29	28	27	26	25							
11													
12	31	32	33	34	35	36							
13													

A. Description of original monument and accessories and/or subsequent restoration:

F-11 1/4 COR. COMMON TO SEC.'S 28 & 33.
GLO COR. SET BY LEWIS CLASON APRIL 1840. W.PINE 12"-S81°W-53 L., Y.PINE 24"-N52°E-38 L.
F. SMITH NOTES-G.F.DELAMATER WIT. 8"OAK-S80°E-76', 8"Y.PINE-S52°W-59', 10"OAK-N56°W-67'.
F. SMITH-SUPERVISOR'S PLAT OF THE N. 1/2 OF THE NE 1/4 OF SEC. 33, T29N, R1E. FEB. 1936.
SURVEY BY G. HENNING APRIL 1960. IRON IN CORNER.
SURVEY BY L. SMITH MAY 13, 1960.
KUHNE'S SUB. BY S. THORSEN JUNE 3, 1960. L. 2 OF PLATS, P. 28.
SURVEY BY L. SMITH 6-14-61. FOUND ROUND STEEL ROD SET G.F.DELAMATER.
LCR BY G. HENNING APRIL 1962. 1 1/4"PIPE IN ROAD.
PLAT OF GREEN ACRES BY N.C.CALDWELL-3-13-1969, L. 2 OF PLATS, P. 71-72.
SURVEY BY SCOTT ENG. CO. INC. 10-8-75, L. 2, P. 119.
SURVEY BY R.S.SCOTT ENG. CO.INC. 7-15-1976. L. 2, P. 194.
ACT 74 BY L BEAUREGARD 6-14-79, L. 1, P. 318. FD. 1/2"BAR & CAP.
SURVEY-R.S.SCOTT ASSO. INC. 8-27-79. L. 2, P. 567. FD. 1/2"BAR & CAP.
SURVEY BY R.S.SCOTT ASSO. INC. 9-7-84. L. 3, P. 253.
SURVEY D. MARLATT 11-28-89.
SURVEY BY R.S.SCOTT ASSO. INC. 8-17-92.
SURVEY BY F. KING 10-13-93. L. 4, P. 147. FD. REC. IRON & CAP.

**APPROVED BY
PEER GROUP**

JUN 20 97

J.E.B.

B. Description of corner evidence found and/or method applied in restoring or
reestablishing corner.


F-11 1/4 CORNER COMMON TO SEC.'S 28 & 33.
FD. 1/2" ROD & CAP
N63°W P.POLE 74.0'
S65°W 17"OAK 68.75'(HENNING)

C. Description of monument for corner and accessories established to perpetuate locating the position of the corner:

F - 11 1/4 CORNER COMMON TO SEC.'S 28 & 33. PLACED MON. BOX & SET REMON. CAP ON 1/2"ROD.
N63°W P.POLE 74.0'
S65°W 17"OAK 68.75'
S48°E TW. 11"OAK 58.37'
N52°E 17"OAK 59.20'

WITNESSES MARKED WITH 40 PENNY SPIKES AND P.S. TAG # 18660.

APPROVED BY PEER GROUP JUNE 20, 1997 AS THE BEST AVAILABLE EVIDENCE OF THE POSITION
OF THE ORIGINAL CORNER.

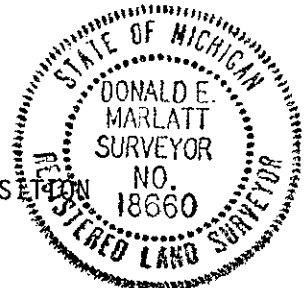

Signed by Donald E Marlatt

Date 12/15/1997

Surveyor's Michigan License No. 18660