

LAND CORNER RECORDATION CERTIFICATE

Filing Requirement of Act 74, Mich. PA 1970

Received
MONTMORENCY COUNTY, MI
01-24-2012 09:37 am.

For Corners In: Montmorency (County)	Located In		Corner Code #
1. Public Land Survey	T		
	T	R	
2. Property Controlling in Section	S	T	R
	S	T	R
3. Miscellaneous Property in Section	S 19	T 29 N	R 03E 14
	S 19	T 29 N	R 03E 16

201200049478
Filed for Record in
MONTMORENCY COUNTY, MI
TERESA WALKER, REGISTER OF DEEDS
01-24-2012 At 09:39:55 am.
LAND CORNER 14.00
Liber 1 Page 764 - 764


Instrument 201200049478
Liber Page 1 764

Register of Deeds Stamp & File Number

4. Lot No: _____ Recorded Plat: _____
5. Private Claims: _____

I, Carl T. Kiiskila, in a field survey on September 20 2011 do hereby state that under requirements of PA 74, Michigan PA of 1970, the corner points mentioned in lines 1 and 2 above were in conformance with regulations and rules therefore as required in the current manual of survey instructions of the United States Department of the Interior, Bureau of Land Management or by a decree of a Court of Law and/or that the corner points mentioned in lines 3, 4 and 5 above were in conformance with the rules of the Michigan Board of Land Surveyors or by a Decree of a Court of Law; established, re-established, monumented, recovered, found as expressed below:

NOTE: Not more than 2 corners, all in the same town and range, may be recorded on this certificate.

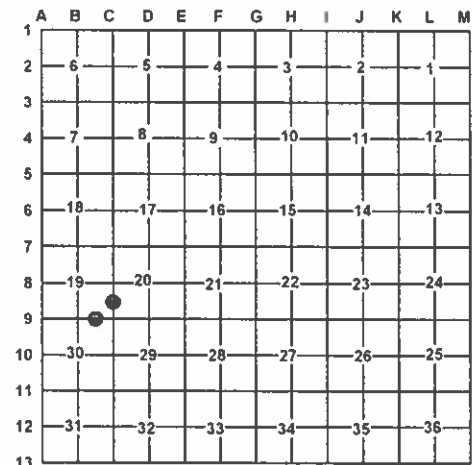

A. Description of original monument and accessories and/or subsequent restoration:

14 - S 1/16 Corner common to sections 19 & 20, T29N,R03E
This corner was not set during the original GLO Survey

16 - E 1/16 Corner common to sections 19 & 30, T29N,R03E
1971 Delmer Porter P.S.#15410 set a concrete monument per standard BLM procedure.

B. Description of corner evidence found and/or method applies in restoring or re-establishing corner:

14 - S 1/16 Corner common to sections 19 & 20, T29N,R03E
Set a 5/8"x34" rerod with 2" Aluminum Cap per standard BLM procedure.

16 - E 1/16 Corner common to sections 19 & 30, T29N,R03E
Found a concrete monument fitting Delmer Porter's Survey in section 19.

C. Description of monument for corner and accessories established to perpetuate locating the position of the corner:

14 - S 1/16 Corner common to sections 19 & 20, T29N,R03E
Stamped 2" dia. alum. cap on 5/8"x 34" rebar

16 - E 1/16 Corner common to sections 19 & 30, T29N,R03E
Added P.S. Cap #33981 to found concrete monument

Wit: N07°E 15.40' to set N&T on W side 9" S. Maple
S71°E 6.60' to set N&T on N side 6" S. Maple
S38°W 17.13' to set N&T on W side 11" Ash
N68°W 5.38' to set N&T on N side 6" S. Maple
Set Blue Carsonite post w/location tag 1' North

Wit: N55°E 20.48' to set N&T on S side 10" Cedar
S36°E 11.83' to set N&T on W side 10" Cedar
S11°W 11.25' to set N&T on NW side 11" Cedar
N75°W 7.88' to set N&T on S side 12" Cedar
Smooth wire fence running North and West
Set Blue Carsonite post w/location tag 1' North.

Carl T Kiiskila

Surveyor's Michigan License No.: 33981



1-23-12