

Montmorency County Remonumentation

Libert 12 Page 12

LAND CORNER RECORDATION CERTIFICATE Filing Requirement of Act 74, Mich. P.A. 1970

08144

A. PANGAR-MCELROY

Dec 20 10 12 AM '93

RECEIVED
MONTMORENCY CITY
REGISTERED DEEDS

For corners in

Montmorency
(County)

Located In:

Corner Code #

1. Public Land Survey

T 29N R 3E

A-10

T 29N R 3E

A-11

T R

T R

APPROVED BY
PEER GROUP

2. Property Controlling
in Section

S T R

S T R

3. Miscellaneous
Property in Sec.

S T R

S T R

NOV 05 93

Register of Deeds Stamp & File Number

4. Lot No. , Recorded Plat

5. Private Claims

	A	B	C	D	E	F	G	H	I	J	K	L	M
2	6		5		4		3		2		1		
3													
4	7		8		9		10		11		12		
5													
6	18		17		16		15		14		13		
7													
8	19		20		21		22		23		24		
9													
10	30		29		28		27		26		25		
11													
12	31		32		33		34		35		36		
13													

I, Donald E. Marlatt, in a field survey on December 10, 1993, do hereby certify that under requirements of P.A. 74, Michigan P.A. of 1970, the corner points mentioned in lines 1 and 2 above were in conformance with regulations and rules therefore as required in the current manual of survey instructions of the United States Department of the Interior, Bureau of Land Management or by a decree of a Court of Law and/or that the corner points mentioned in lines 3, 4 and 5 above were in conformance with the rules of the Michigan Board of Land Surveyors or by a Decree of a Court of Law; established, re-established, monumented, re-monumented, recovered, found as expressed below:

NOTE: Not more than 4 corners, all in the same town and range, may be recorded on this certificate.

A. Description of original monument and accessories and/or subsequent restoration:

(A-10) W. 1/4 Cor. Sec. 30, T29N, R3E
Post set by Lewis Clason 1839.
Tamarack 9-S 52 W-31, Cedar 12-N 28 W-36
M.S.H.D. Proj. 60-10 field notes 1956.
Act 74 by Ken Ostling L. 1, P. 187.
Survey by Ken Ostling 1975.
Survey by R.S. Scott Assoc. Inc. L. 2, P. 450.
Survey by D.E. Marlatt 10-13-1981.
Survey by D.E. Marlatt 7-2-1989.
Survey by D.E. Porter 1993.

(A-11) S.W. Cor. Sec. 30, T29N, R3E
Post set by Lewis Clason 1839.
Hd. Maple 10-S 73 W-35
W. Pine 20-N 41 W-14
W. Pine 36-N 55 E-19
Hd. Maple 8-S 34 E-23
M.S.H.D. Proj. 60-10 field notes 1956.
Act 74 by Ken Ostling L. 1, P. 187.
Survey by Ken Ostling 1975.
Act 74 by Norm Quaine L. 1, P. 479 & L. 1, P. 501.
Survey by D.E. Porter for Shell Western E. & P. 1993.

Description of corner evidence found and/or method applied in restoring or reestablishing corner:

(A-10) W. 1/4 Cor. Sec. 30, T29N, R3E
Fnd. Conc. Mon.
S 80° W 9" Spruce 77.0'
N 50° E 9" Balsam 23.0'

No evidence of original corner.

(A-11) S.W. Cor. Sec. 30, T29N, R3E
Fnd. Conc. Mon.
N 60° W 35.11' 6" Oak
S 59° W 69.60' P. Pole
N 43° E 69.65' 18" Cedar
S 51° E 43.60' 14" Basswood
No evidence of original corner

The Peer Group approved (A-10) as a perpetuation of the original government corner.

The Peer Group approved (A-11) as the best available evidence of the reestablishment of original corner.

C. Description of monument for corner and accessories established to perpetuate locating the position of the corner:

(A-10) W. 1/4 Cor. Sec. 30, T29N, R3E
Placed Re-Mon. cap on Conc. Mon.
S 1° E 4" Spruce 13.4'
S 65° W 12" Balsam 43.87'
N 53° E 9" Balsam 23.08'
N 18° W 11" Poplar 27.51'


(A-11) S.W. Cor. Sec. 30, T29N, R3E
Placed Re-Mon. cap on Conc. Mon.
N 43° E 18" Cedar 69.63'
S 52° E 12" Basswood 43.65'
S 60° W P. Pole 69.60'
N 60° W 6" Oak 35.08'

Witnesses marked with 30 penny spikes & I.D. tags #18660.

Signed by Donald E. Marlatt

Date Dec 15, 1993

Surveyor's Michigan License No. 18660

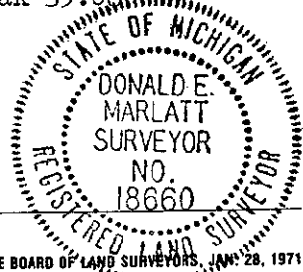

FORM APPROVED BY MICHIGAN STATE BOARD OF LAND SURVEYORS, JAN. 28, 1971
REVISED MAY 14, 1975
REVISED JAN., 1983