

LAND CORNER RECORDATION CERTIFICATE  
Filing Requirement of Act 74, Mich. P.A. 1970

For corners in

Montmorency  
(County)

Located In:

Corner Code =#

1. Public Land Survey

T 30N R 1E  
T 30N R 1E  
T 30N R 1E

I-1

H-1

I-2

2. Property Controlling  
in Section

S T R  
S T R

3. Miscellaneous  
Property in Sec.

S T R  
S T R

Register of Deeds Stamp & File Number

4. Lot No. , Recorded Plat

5. Private Claims

I, Carl R. Johnson, in a field survey on June 4, 19 90,  
do hereby certify that under requirements of P.A. 74, Michigan P.A. of 1970, the corner points mentioned  
in lines 1 and 2 above were in conformance with regulations and rules therefore as required in the  
current manual of survey instructions of the United States Department of the Interior, Bureau of Land  
Management or by a decree of a Court of Law and/or that the corner points mentioned in lines 3, 4 and 5  
above were in conformance with the rules of the Michigan Board of Land Surveyors or by a Decree of a  
Court of Law; established, re-established, monumented, re-monumented, recovered, found as  
expressed below:

NOTE: Not more than 4 corners, all in the same town and range, may be recorded  
on this certificate.

A. Description of original monument and accessories and/or subsequent restoration:

B. Description of corner evidence found and/or method applied in restoring or reestablishing corner:

I-1 Set by proportionate measurement of closing corners 1 mile east and 1 mile west.  
Set on closing twp. line  
H-1 Set midway between closing section corners on the twp. line.  
I-2 Set by single proportionate measurement between section corners.

C. Description of monument for corner and accessories established to perpetuate locating the position of the corner:

I-1 NE Corner section 3  
Set DNR Mon.  
Cedar 10" S67°W 5.2 ft.  
Cedar 7" S41°E 11.1 ft.

H-1 N1/4 Corner Sec. 3  
Set DNR Mon.  
Twin Maple 8" S21°E 26.8 ft.  
Yellow Birch 10" S59°W 23.5 ft.


I-2 E1/4 Corner Sec. 3  
Set DNR Mon.  
Maple 5" N23°E 21.5 ft.  
Maple 8" S84°E 18.7 ft.  
Maple 5" S42°W 28.6 ft.  
Maple 5" N35°W 23.4 ft.  
Centerline of Trail Rd. North 35 ft.

	A	B	C	D	E	F	G	H	I	J	K	L	M
2	6		5		4		3		2		1		
3													
4	7		8		9		10		11		12		
5													
6	18		17		16		15		14		13		
7													
8	19		20		21		22		23		24		
9													
10	30		29		28		27		26		25		
11													
12	31		32		33		34		35		36		
13													

Signed by

*Carl R. Johnson*

Surveyor's Michigan License No. 30083

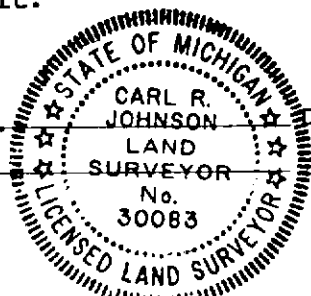

Date

6/12/90

FORM APPROVED BY MICHIGAN STATE BOARD OF LAND SURVEYORS, JAN. 28, 1971  
REVISED MAY 14, 1975  
REVISED JAN., 1983