


LAND CORNER RECORDATION CERTIFICATE
Filing Requirement of Act 74, Mich. PA 1970

For Corners In: Montmorency Located In Corner Code #
1. Public Land Survey T 30 N R 02 E G9
T 30 N R 02 E H10
2. Property Controlling in Section S T R
S T R
3. Miscellaneous Property in Section S T R
S T R
4. Lot No: Recorded Plat:
5. Private Claims:

Register of Deeds Stamp & File Number

I, Carl T. Kiiskila, in a field survey on October 20 2010 do hereby state that under requirements of PA 74, Michigan PA of 1970, the corner points mentioned in lines 1 and 2 above were in conformance with regulations and rules therefore as required in the current manual of survey instructions of the United States Department of the Interior, Bureau of Land Management or by a decree of a Court of Law and/or that the corner points mentioned in lines 3, 4 and 5 above were in conformance with the rules of the Michigan Board of Land Surveyors or by a Decree of a Court of Law; established, re-established, monumented, recovered, found as expressed below:

NOTE: Not more than 2 corners, all in the same town and range, may be recorded on this certificate.

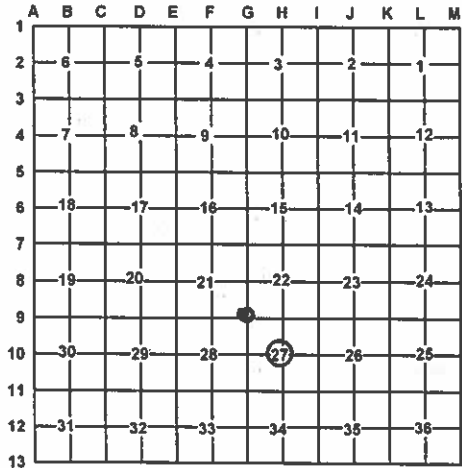

A. Description of original monument and accessories and/or subsequent restoration:

G-9 - Section Corner comm. to sec.'s 21, 22, 27, 28, T30N,R02E H-10 - Center 1/4 Corner, Section 27, T30N,R02E
2000 - Remon L.C.R.C. - L.12, p.414 - Larry G. Beauregard, P.S.#18654 - Found 2 1/2" conc. mon. at corner, both 4" conc. mon. wits. by Smith & rec. wits. by Porter. Placed 3 1/4" alum. remon cap on top.
N45°E 50.00' fnd. 4" conc. mon.
S45°W 50.00' fnd. 4" conc. mon.
N04°E 42.75' 14" Oak
N44°E 45.68' 24" Oak
None

B. Description of corner evidence found and/or method applies in restoring or re-establishing corner:

G9 - Section Corner comm. to sec.'s 21, 22, 27, 28, T30N,R02E H-10 - Center 1/4 Corner, Section 27, T30N,R02E
Found no evidence of monument. Probably taken out due to road construction. All four previous witnesses of record were present and in good condition. Reset corner with standard DNR monument in mon. box using coordinates from 2001 DNR Survey (Plan No. R-60-AY). Position for corner fits witnesses well. Accepted set standard DNR monument as the best available evidence of the position of the original corner.
Set stamped 2" dia. aluminum cap on 5/8"x34" rebar per standard BLM procedure (intersection of 1/4 lines). Found no other evidence to dispute the location for the corner.

C. Description of monument for corner and accessories established to perpetuate locating the position of the corner:

G9 - Section Corner comm. to sec.'s 21, 22, 27, 28, T30N,R02E H-10 - Center 1/4 Corner, Section 27, T30N,R02E
Stamped 4" dia. alum cap on 1"x 36" galv. pipe in mon. box Stamped 2" dia. aluminum cap on 5/8"x34" rebar
Wit: \*N29°E 45.67' to fd. N&T on E side 25" Oak Wit: N70°E 31.53' to set N&T on NW side 6" B. Cherry
\*N38°E 49.85' to fd. 4" dia. conc. monument S03°W 8.91' to set N&T on E side 6" S. Maple
\*S39°W 50.10' to fd. 4" dia. conc. monument S60°W 10.49' to set N&T on S side 8" R. Maple
\*N10°W 42.66' to fd. N&T on E side 16" Oak N32°W 1.60' to set N&T on SW side 6" Balsam Fir
Set Blue Carsonite post w/location tag 1' North.

\* Witness of previous record.
Carl T. Kiiskila
Surveyor's Michigan License No.: 33981



12-27-10