


NOV 23 1999

SECTION

Liber 00012 Page 0355

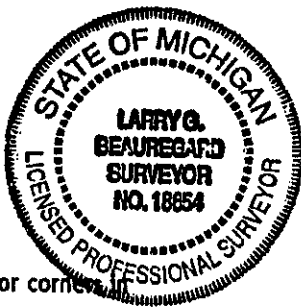

## MONTMORENCY COUNTY REMONUMENTATION

LAND CORNER RECORDATION CERTIFICATE  
Filing Requirement of Act 74, Mich. P.A. 1970

For corner

Montmorency  
(County)Located In:  
Briley  
(Township)

Corner Code #

1. Public Land Survey

T 30N R 2EK-12T RT RT RT R2. Property Controlling  
In SectionST RST R3. Miscellaneous  
Property in Sec.ST RST R

4. Lot No. \_\_\_\_\_, Recorded Plat \_\_\_\_\_

5. Private Claims \_\_\_\_\_

STATE OF MICHIGAN  
MONTMORENCY COUNTY  
Recorded & Filed

08-10-1999 14:45:47

TERESA WALKER  
REGISTER OF DEEDSRegister of Deeds Stamp & File  
Number

I, Larry G. Beauregard, in a field survey on April, 1999 do hereby certify that under requirements of P.A. 74, Michigan P.A. of 1970, the corner points mentioned in lines 1 and 2 above were in conformance with regulations and rules therefore as required in the current manual of survey instructions of the United States Department of the Interior, Bureau of Land Management or by a decree of a Court of Law and /or that the corner points mentioned in lines 3, 4 and 5 above were in conformance with the rules of the Michigan Board of Land Surveyors or by a Decree of a Court of Law; established, re-established, monumented, re-monumented, recovered, found as expressed below:

NOTE: Not more than 2 corners, all in the same town and range, may be recorded on this certificate.

A. Description of original monument and accessories and/or subsequent restoration:  
K-12 - 1/4 Cor. 35 & 36, T30N, R2E

Lewis Clason, D.S. Set Qr. Sec. Post. Wil's mkd. (Aspen 8" S62E 18 lks)  
(Y. Pine N52W 19 lks).

B. Description of corner evidence found and/or method applied in restoring or reestablishing corner:

April, 1999 - Fnd. No evidence of corner or references. Set a 3 1/4" Aluminum Re-mon. cap on a 4" dia. X 36" conc. mon. by Single Proportionate method between K-11 & K-13.

C. Description of monument for corner and accessories established to perpetuate locating the position of the corner:  
K-12 - 1/4 Cor. 35 & 36, T30N, R2E

3 1/4" Aluminum Re-mon. cap on 4" dia. X 36" concrete monument.

Accepted as a careful and faithful establishment of the position of the corner.

Approved by the Peer Group on July 20, 1999.

S85°E	19.05'	4" Maple (in clump)	(Placed 60d Spike & P.S. Tag 18654)
S48°E	29.53'	7" Norway	( " " " " " " )
N42°E	28.47'	5" Norway	( " " " " " " )
S20°W	12.12'	7" W. Pine	( " " " " " " )

	A	B	C	D	E	F	G	H	I	J	K	L	M
1													
2	6		5		4		3		2		1		
3													
4	7		8		9		10		11		12		
5													
6	16		17		18		19		20		21		
7													
8	15		20		21		22		23		24		
9													
10	20		25		26		27		28		29		
11													
12	31		32		33		34		35		36		
13													

APPROVED BY  
PEER GROUP

JUL 20 99

Signed by Larry G. Beauregard  
Surveyor's Michigan License No. 18654Date, August 5, 1999