

SURVEY & REMONUMENTATION

JAN 22 2001

Montmorency County Remonumentation

Liber 00012 Page 0422

SECTION

For corners in

LAND CORNER RECORDATION CERTIFICATE

Filing Requirement of Act 74, Mich. P.A. 1970

MONTMORENCY

(County)

Located In: BRILEY

Corner Code #

1. Public Land Survey

T 30N R 2E D-5

2. Property Controlling in Section

S T R

3. Miscellaneous Property in Sec.

S T R

STATE OF MICHIGAN
MONTMORENCY COUNTY
Recorded & Filed

11-13-2000 13:32:42

TERESA WALKER
REGISTER OF DEEDS


Register of Deeds Stamp & File Number

4. Lot No. , Recorded Plat

5. Private Claims

I, FREDERICK J. KING, in a field survey on MARCH 21, 2000 do hereby state that under requirements of P.A. 74, Michigan P.A. of 1970, the corner points mentioned in lines 1 and 2 above were in conformance with regulations and rules therefore as required in the current manual of survey instructions of the United States Department of the Interior, Bureau of Land Management or by a decree of a Court of Law and/or that the corner points mentioned in lines 3, 4 and 5 above were in conformance with the rules of the Michigan Board of Land Surveyors or by a Decree of a Court of Law; established, re-established, monumented, recovered, found as expressed below:

NOTE: Not more than 2 corners, all in the same town and range, may be recorded on this certificate.

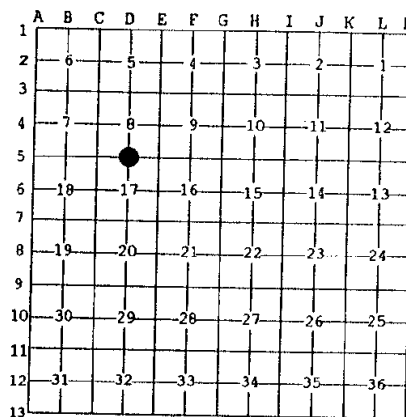

A. Description of original monument and accessories and/or subsequent restoration:

D-5 - 1/4 CORNER COMMON TO SECTIONS 8 & 17

June 1840 - Orig Post set by Lewis Clason, DS - (1)N38°E-25 lks (16.50') 18" Hem. (2)S57°W-22 lks (14.52') 22" Hem- Pg.45
1941 - 2 1/2" Conc Mon set by Frank Smith, PS#754 -Info obtained from L.G. Beauregard, PS#18654 - (3)N45°E-50.0'-4" Conc Mkr (4)S45°W-50.0'-4" Conc Mkr.

Dec. 1975 - Act 132 by D.E. Marlatt, PS#18660 - Rec. L. 2, Pg. 157 - Exist Conc. Mon - No Witnesses

B. Description of corner evidence found and/or method applied in restoring or reestablishing corner:

D-5 - 1/4 CORNER COMMON TO SECTIONS 8 & 17

Fnd 4" Conc Mon (Rec as 2 1/2")

Witnesses - Fnd Rec. 3 & 4



THIS CORNER APPROVED BY COUNTY PEER REVIEW ON JULY 18, 2000, AS THE BEST AVAILABLE EVIDENCE OF THE RE-ESTABLISHMENT OF THE ORIGINAL CORNER.

C. Description of monument for corner and accessories established to perpetuate locating the position of the corner:

D-5 - 1/4 CORNER COMMON TO SECTIONS 8 & 17

Placed 3 1/4" Aluminum Montmorency County Re-Mon Cap on Fnd 4" Conc Mon. * Corner is on NE side of Fnc Cor Post (Wit#3) - N45°E - 50.12' (R-50.0') - 4" Conc Mon * N70°E - 113.32' - Set S&T - N side Pwr Pole #AG369R
S10°W - 42.54' - Set S&T - E side Pwr Pole #AG368L
(Wit#4) - S45°W - 50' (R-50.0') - Fnd Rec 4" Mon Badly Tipped (Appears to have been hit during Pwr Line Const)
N85°W - 55.21' - Set S&T - S side 12" Maple * N10°W - 14.45' - Set S&T - E side 12" Maple

Typical Wit Set = 16-D Spk & Plastic ID Tag #25852

APPROVED BY
PEER GROUP

Signed by

Frederick J. King

Date October 30, 2000

JUL 18 00

Surveyor's Michigan License No. 25852

L.S.B.