

# SURVEY & REMONUMENTATION

JAN 22 2001

Liber 00012 Page 0405

SECTION

## MONTMORENCY COUNTY REMONUMENTATION LAND CORNER RECORDATION CERTIFICATE Filing Requirement of Act 74, Mich. P.A. 1970

For corners in

Located in:

Montmorency  
(County)

Briley  
(Township)

Corner Code #

1. Public Land Survey

T 30N R 2E

D-9

2. Property Controlling  
in Section

S

T R

T R

3. Miscellaneous  
Property in Sec.

S

T R

T R

4. Lot No. \_\_\_\_\_, Recorded Plat \_\_\_\_\_

5. Private Claims \_\_\_\_\_

STATE OF MICHIGAN  
MONTMORENCY COUNTY  
Recorded & Filed

10-27-2000 11:55:08

TERESA WALKER  
REGISTER OF DEEDS

Register of Deeds Stamp & File Number

I, Larry G. Beauregard, in a field survey on MARCH, 20 00, do hereby certify that under requirements of P.A. 74, Michigan P.A. of 1970, the corner points mentioned in lines 1 and 2 above were in conformance with regulations and rules thereof as required in the current manual of survey instructions of the United States Department of the Interior, Bureau of Land Management or by a decree of a Court of Law and/or that the corner points mentioned in lines 3, 4 and 5 above were in conformance with the rules of the Michigan Board of Land Surveyors or by a Decree of a Court of Law; established, re-established, monumented, re-monumented, recovered, found as expressed below:

NOTE: Not more than 2 corners, all in the same town and range, may be recorded on this certificate.

A. Description of original monument and accessories and/or subsequent restoration:

D-9 ¼ corner between Sections 20 & 29:

1840 Lewis Clason D.S. Marked Tam. 7" dia. For Qr. Sec. Post.

1941 Frank N. Smith RLS #754 ran a random line between Sections 20 & 29 & fnd. old ¼ post 17' South of his random. Then set set 2½" concrete monument at post location for corner. Wit's. Mkd. (N45°W 50' 4" dia. Mon.) (S45°E 50' 4" dia. Mon.)

1974 Delmer E. Porter P.S. #15410. Fnd. Concrete mon. at corner. Filed LCRC Rec. L. 1, P. 108. Wit's. Fnd. (Both monuments by Smith) Wit. Mkd. (S85°E 23.45' 5" Cedar)

1987 Larry G. Beauregard P.S. #18654, (Surveyor for Scott Assoc. Inc.) Fnd. concrete monument at corner & Rec. Wit's. in a section divisional survey of Sec. 20. No new Wit's. Mkd.

1990 Donald E. Marlatt P.S. #18660. Fnd. concrete monument at corner & Rec. Wit's. Filed LCRC Rec. L. 1, P. 467, (Same Wit's. as recorded by Porter)

B. Description of corner evidence found and/or method applied in restoring or reestablishing corner:

March 2000: Fnd. 2½" concrete monument at corner. Placed a 3¼" aluminum Re-mon. cap on top.

C. Description of monument for corner and accessories established to perpetuate locating the position of the corner:

D-9 ¼ corner between Sections 20 & 29.

2½" concrete monument with a 3¼" aluminum Mont. Co. Re-mon. cap.

Accepted as the best available evidence of the original corner.

Accepted by the peer group on July 18, 2000.

N 45° W 50.0' Fnd. 4" Conc. Mon. (R)


S 45° E 50.0' Fnd. 4" Conc. Mon. (R)

S 78° E 23.47' 8" Twn. Cedar (R)

South 24.32' 9" Cedar (NBT)

N 88° W 17.88' 8" Balsam (NBT)


Placed 60d penny spike & P.S. tag #18654 (typ).

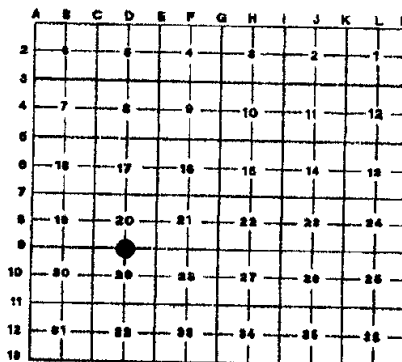

APPROVED BY  
PEER GROUP

JUL 18 00

*LGB*

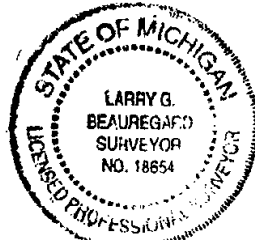

Signed by Larry G. Beauregard

Date 10-27-00

Surveyor's Michigan License No. 18654