

SURVEY & REMONUMENTATION

JAN 22 2001

Montmorency County Remonumentation

SECTION

LAND CORNER RECORDATION CERTIFICATE
Filing Requirement of Act 74, Mich. P.A. 1970

Liber 00012 Page 0432

For corners in

MONTMORENCY
(County)

Located in: BRILEY

Corner Code #

1. Public Land Survey

T 30N R 2E 9-7

T R

T R

T R

2. Property Controlling
in Section

S T R

S T R

3. Miscellaneous
Property in Sec.

S T R

S T R

4. Lot No. , Recorded Plat

5. Private Claims

STATE OF MICHIGAN
MONTMORENCY COUNTY
Recorded & Filed


11-13-2000 13:35:34

TERESA WALKER
REGISTER OF DEEDS

Register of Deeds Stamp & File Number

I, FREDERICK J. KING, in a field survey on APRIL 6, 2000, do hereby state that under requirements of P.A. 74, Michigan P.A. of 1970, the corner points mentioned in lines 1 and 2 above were in conformance with regulations and rules therefore as required in the current manual of survey instructions of the United States Department of the Interior, Bureau of Land Management or by a decree of a Court of Law and/or that the corner points mentioned in lines 3, 4 and 5 above were in conformance with the rules of the Michigan Board of Land Surveyors or by a Decree of a Court of Law; established, re-established, monumented, recovered, found as expressed below:

NOTE: Not more than 2 corners, all in the same town and range, may be recorded on this certificate.

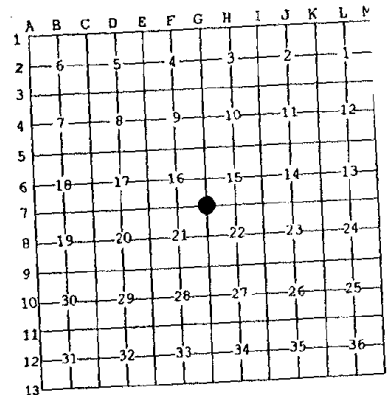

A. Description of original monument and accessories and/or subsequent restoration:

G-7 - CORNER COMMON TO SECTIONS 15, 16, 21 & 22
June 1840 - Orig Post set by Lewis Clason, DS - (1)N57°E-5 lks -(3.30') 8" Birch (2)S25°W-No Dist - 8" Cedar - Pg. 444
1941 - 2 1/2" Conc mon set by Frank Smith, PS#754 - Info obtained from L.G. Beauregard, PS#18654 - Found Old Stake
(3)N45°W-50.0'-4" Conc Mkr. - (4)S45°E-50.0'-4" Conc Mkr.
Circa 1960- Witnesses obtained from D.E. Porter, PS#15410 - Not Recorded - 2 1/2" Conc Mon. (5)S67°W-45.0' - 16" W. Pine
(6)N57°W-41.4'-29" W. Pine (7)S31°E-21.4'-22" W. Pine
Aug. 1990 - Act 132 by D.E. Marlatt, PS#18660 - Rec. L.S. pg. 570 - Fnd mon - (8)NORTH-8.54'-10" Trl Maple
(9)S05°E-20.34'-16" Poplar (10)N88°E-40.32'- 8" Maple

B. Description of corner evidence found and/or method applied in restoring or reestablishing corner:

G-7 - CORNER COMMON TO SECTIONS 15, 16 21 & 22
Fnd 5" Conc Mon. (Rec. as 2 1/2")
Witnesses: Fnd Rec. 5, 8, 9 & 10



THIS CORNER APPROVED BY COUNTY PEER REVIEW ON JULY 18, 2000, AS THE BEST AVAILABLE EVIDENCE OF THE RE-ESTABLISHMENT OF THE ORIGINAL CORNER.

C. Description of monument for corner and accessories established to perpetuate locating the position of the corner:

G-7 - CORNER COMMON TO SECTIONS 15, 16, 21 & 22

Placed 3 1/4" Aluminum Montmorency County Re-Mon Cap on Fnd 5" Conc. Mon.
Corner is 1.4' W of N-S Fnc with Steel Fnc Post 0.7' S of Corner.
(Wit #8) - N05°W (R-NORTH) - 8.74' (R-8.54') - Set S&T above Fnd Spk - E side 18" Tirlple Maple
N80°E - 1.4' - SW Face of wood Fnc Post.
(Wit #10) - N88°E - 40.47' (R-40.32') - Set S&T above fnd Spk - S side 10" Maple.
(Wit #9) - S05°E - 20.54' (R-20.34') - Set S&T above fnd Spk - W side 20" Poplar.
(Wit #5) - S67°W - 45.37' (R-45.0') - Set S&T above fnd spk N side 20" White Pine.

Typical Witness Set = 16-D Spike & Plastic ID Tag #25852

Signed by

Surveyor's Michigan License No. 25852

Date October 30, 2000

APPROVED BY
PEER GROUP

JUL 18 00

L.G.B.