

LAND CORNER RECORDATION CERTIFICATE

Filing Requirement of Act 74, Mich. PA 1970

For Corners In:

Montmorency

Located In

Corner Code #

(County)

1. Public Land Survey	T	_____	R	_____	_____
	T	_____	R	_____	_____
2. Property Controlling in Section	S	20	T	30N	R 2E 14
	S	20	T	30N	R 2E 10
3. Miscellaneous Property in Section	S	_____	T	_____	R _____
	S	_____	T	_____	R _____


4. Lot No: _____ Recorded Plat: _____

5. Private Claims: _____

I, Carl T. Kiiskila, in a field survey on April 26, 2001 do hereby state that under requirements of PA 74, Michigan PA of 1970, the corner points mentioned in lines 1 and 2 above were in conformance with regulations and rules therefore as required in the current manual of survey instructions of the United States Department of the Interior, Bureau of Land Management or by a decree of a Court of Law and/or that the corner points mentioned in lines 3, 4 and 5 above were in conformance with the rules of the Michigan Board of Land Surveyors or by a Decree of a Court of Law; established, re-established, monumented, recovered, found as expressed below:

NOTE: Not more than 2 corners, all in the same town and range, may be recorded on this certificate.

Register of Deeds Stamp & File Number

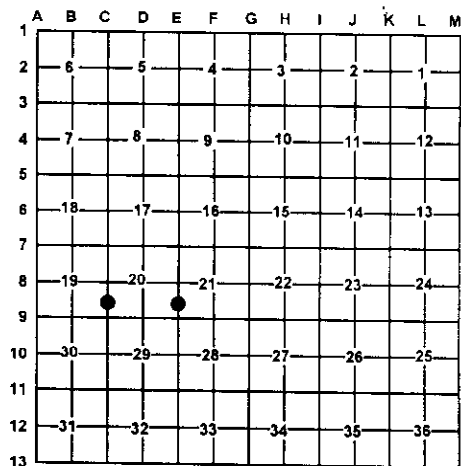

A. Description of original monument and accessories and/or subsequent restoration:

14- This corner position was not established during the original government survey.

10- Larry G. Beauregard RLS # 18654 Cert. of Survey Nov. 1987 Set 1/2" X 18" bar and RLS cap by single proportion.
Wit: N50°W 110.10' P. Pole
N30°E 76.32' 12" B. Wd
N15°W 32.15' 24" Cedar
Ex. 1" pipe & 3" Sq. stake 1' west of corner set

B. Description of corner evidence found and/or method applies in restoring or re-establishing corner:

14- Established the Southeast corner of the Northeast quarter of the Southeast quarter of section 20 as per B.L.M. instructions for the subdivision of a section.

10- Found 1/2" capped iron Larry G. Beauregard RLS # 18654

C. Description of monument for corner and accessories established to perpetuate locating the position of the corner:

14- Set 5/8" X 32" rerod with P.S. cap #33981

Wit: 24" Red Pine N59°W 42.96'
24" Red Pine N03°E 66.81'
18" Red Pine S29°W 35.54'
Concrete mon. North 5.35'
Carsonite Post North 1'±

10- Found 1/2" capped rod set 5/8" X 32" rerod with P.S. cap #33981

Wit: 20" Cedar N04°W 32.61'
3" Balsam N33°E 20.03'
6" Ash S22°E 57.20'
3" Ash S70°W 28.41'
Carsonite Post North 1'±

Signed by:

Carl T. Kiiskila

Date:

2-7-02

Surveyor's Michigan License No.:

33981

