

✓

STATE OF MICHIGAN
DEPARTMENT
OF
NATURAL RESOURCES

LAND CORNER RECORD


MONTMORENCY COUNTY
T 31 N R 1 E

DESCRIPTION OF CORNER Center of the SE 1/4

CORNER MONUMENT Set 2' of 1" pipe

DATE MONUMENT PLACED AND WITNESSED 9-8-72

WITNESSES TO CORNER.....

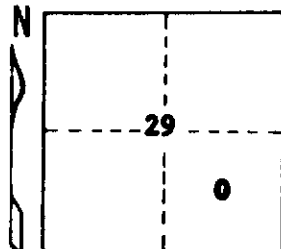

9" R. Oak S 45 W 34.65'


7" R. Oak S 50 E 35.6'

AND

CIRCLE CORNER REGISTERED

DESCRIPTION IN DETAIL AS TO HOW CORNER WAS LOCATED AND IDENTIFIED OR RESTORED.

Corner set by standard survey procedure for the subdivision of sections.

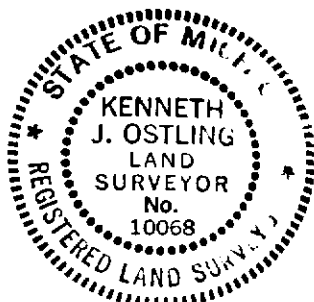

SURVEYOR'S SEAL

SIGNED

Kenneth J. Ostling
REGISTERED LAND SURVEYOR

DATE

9-12-72

DISTRIBUTION:

Forestry Division, Lansing