

LAND CORNER RECORDATION CERTIFICATE
Filing Requirement of Act 74, Mich. P.A. 1970

For corners in

Montmorency
(County)

Located In:

Corner Code ~~##~~

- | | | |
|------------------------------------|-----------------|------|
| 1. Public Land Survey | T 31N R 2E | H-11 |
| | T 31N R 2E | H-10 |
| | T 31 R 2 | |
| | T 31 R 2 | |
| 2. Property Controlling in Section | S 27 T 31N R 2E | 2 |
| | S 27 T 31N R 2E | 15 |
| 3. Miscellaneous Property in Sec. | S T R | |
| | S T R | |

Register of Deeds Stamp & File Number

4. Lot No. _____, Recorded Plat _____
5. Private Claims _____

I, Carl R. Johnson, in a field survey on May 14, 19 90, do hereby certify that under requirements of P.A. 74, Michigan P.A. of 1970, the corner points mentioned in lines 1 and 2 above were in conformance with regulations and rules therefore as required in the current manual of survey instructions of the United States Department of the Interior, Bureau of Land Management or by a decree of a Court of Law and/or that the corner points mentioned in lines 3, 4 and 5 above were in conformance with the rules of the Michigan Board of Land Surveyors or by a Decree of a Court of Law; established, re-established, monumented, re-monumented, recovered, found as expressed below:

NOTE: Not more than 4 corners, all in the same town and range, may be recorded on this certificate.


A. Description of original monument and accessories and/or subsequent restoration:

B. Description of corner evidence found and/or method applied in restoring or reestablishing corner:

- H-11 Found old square post in place. Best evidence available to perpetuate corner location
- H-10 Set at computed intersection of 1/4 lines.
- 2 Set by standard survey procedure for subdivision of a section.
- 15 Set by standard survey procedure for subdivision of a section.

C. Description of monument for corner and accessories established to perpetuate locating the position of the corner:

- | | |
|-------------------------|------------------------------|
| H-11 S1/4 Corner | 2 E1/8 on N. Side |
| Set DNR Monument | Set 5/8" Bar with cap |
| 6" Cedar N64°W 21.3ft | 7" spruce N38°W 10.7ft |
| 5" Spruce N81°E 13.8ft | 14" Cedar S25°E 9.9ft |
| 6" Cedar S39°E 15.7ft | |
| 4" Spruce S79°W 15.2ft | 15 W1/8 on South Side |
| H-10 Center of section | Set 5/8" Bar with cap |
| Set DNR Monument | 4" Maple N11°W 13.9 ft |
| 6" Spruce N60°E 13.0ft | 7" Double Maple S25°E 13.6ft |
| 7" W.Birch S02°E 35.2ft | 1" Iron Pipe S44°W 15.0ft |
| 4" Spruce S36°W 16.1ft | |

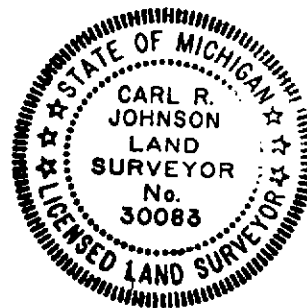

Signed by Carl R. Johnson Date 5/24/90

Surveyor's Michigan License No. 30083