

LAND CORNER RECORDATION CERTIFICATE
FILING REQUIREMENT OF ACT 74, MICH. P.A.1970

| FOR CORNERS OF--: | LOCATED IN--: | CORNER CODE NUMBER |
|---|---------------|-------------------------|
| 1. PUBLIC LAND SURVEY_____ T. <u>31</u> N. <u>●</u> R. <u>3</u> E. <u>●</u> | | <u>H-11; I-11; I-12</u> |
| 2. PROPERTY CONTROLLING IN SECTION <u>34</u> T. <u>31</u> N. <u>●</u> R. <u>3</u> E. <u>●</u> | | <u>1; 2</u> |
| 3. MISCELLANEOUS PROPERTY IN SECTION _____ T. _____ S. R. _____ W. _____ | | |
| 4. LOT NO. _____, RECORDED PLAT _____ | | |
| 5. PRIVATE CLAIMS _____ | | |

Montmorency

REGISTER OF DEEDS STAMP AND
FILING NUMBER

I, Kenneth J. Ostling do hereby certify that under requirements of P.A. 74, Michigan P.A. of 1970, the corner points mentioned in lines 1 and 2 above (identified with circles on index code diagram - over) were, in a field survey on May 20, 1974, established, re-established, monumented, re-monumented, recovered or restored as expressed below and in conformance with regulations and rules therefore as required in the current manual of survey instructions of the United States Department of the Interior, Bureau of Land Management or by a decree of a court of law. Furthermore, that the corner points mentioned in lines 3, 4 and 5 above were, in a field survey on 19, found, recovered, restored, established or re-established as expressed below and in conformance with the rules of the Michigan State Board of Registration for Land Surveyors or, by a Decree of a Court of law:

A. Description of original monument and accessories and/or subsequent restoration:

B. Description of corner evidence found and/or method applied in restoring or re-establishing corner:

- H-11 Found $\frac{1}{2}$ " pipe in road in line with fences north and south.
- I-11 Found concrete monument in place, previously of record as a railroad iron.
- I-12 Found 3"x3" square cedar stake. Cedar stump with axe marks in place for northeast OBT.
- 1 Set by standard survey procedure for the subdivision of sections.
- 2 Set by standard survey procedure for the subdivision of sections. Somebody's $\frac{1}{4}$ " pipe 5.45' west erroneously located.

C. Description of monument for corner and accessories established to perpetuate locating the position of the corner:

| H-11 | I-11 | I-12 |
|-----------------------------|---|--------------------------------|
| $\frac{1}{2}$ " pipe | $\frac{1}{2}$ " rerod in cong. monument | DNR monument |
| 4" Balsam N44°E 91.3 | 7" Balsam S48°W 97.7 | 7" Cedar S61°W 11.8 |
| 8" Balsam N13°E 77.1 | 9" R. Pine S22°E 120.4 | 7" Cedar N13°W 17.3 |
| Fence in line N & S | | |
| 1 | | 2 |
| $2\frac{1}{2}$ ' of 1" pipe | | $2\frac{1}{2}$ ' of 1" pipe |
| 19" R. Oak S60°E 74.8 | | 6" Cedar SOUTH 41.9 |
| 26" Twn. R. Oak S04°E 29.3 | | Twin 5" Cedars S40°E 60.8 |
| | | $\frac{1}{4}$ " pipe WEST 5.45 |

SIGNED BY Kenneth J. Ostling

DATE 6-24-74

SURVEYOR'S MICHIGAN REGISTRATION NO. 10068

FOR STATE AND UNITED STATES AGENCIES:


SIGNED BY _____ CHIEF OF SURVEY PARTY

DATE _____

APPROVED AND SIGNED BY _____ MICHIGAN REGISTERED LAND SURVEYOR

DATE _____

(SEAL)

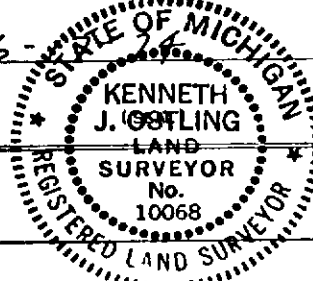

SURVEYOR'S MICHIGAN REGISTRATION NO. _____

MONTMORENCY COUNTY