

LAND CORNER RECORDATION CERTIFICATE
Filing Requirement of Act 74, Mich. P.A. 1970

For corners in
MONTMORENCY
(County)

Located in:

Corner Code ##

1. Public Land Survey

T 31N R 3E

H-4

T R

T R

T R

T R

2. Property Controlling
in Section

S 10

T R

5

S 10

T R

6

3. Miscellaneous
Property in Sec.

S

T R

S

T R

Register of Deeds Stamp & File Number

4. Lot No. , Recorded Plat

5. Private Claims

I, CARL R. JOHNSON, in a field survey on DECEMBER 18, 19 91,
do hereby certify that under requirements of P.A. 74, Michigan P.A. of 1970, the corner points mentioned
in lines 1 and 2 above were in conformance with regulations and rules therefore as required in the
current manual of survey instructions of the United States Department of the Interior, Bureau of Land
Management or by a decree of a Court of Law and/or that the corner points mentioned in lines 3, 4 and 5
above were in conformance with the rules of the Michigan Board of Land Surveyors or by a Decree of a
Court of Law, established, re-established, monumented, re-monumented, recovered, found as
expressed below:

NOTE: Not more than 4 corners, all in the same town and range, may be recorded
on this certificate.

A. Description of original monument and accessories and/or subsequent restoration:

H-4

5

6

	A	B	C	D	E	F	G	H	I	J	K	L	M
2	6	5	4	3	2	1							
3													
4	7	8	9	10	11	12							
5													
6	16	17	18	19	20	21	22	23	24				
7													
8	19	20	21	22	23	24							
9													
10	30	29	28	27	26	25							
11													
12	31	32	33	34	35	36							
13													

B. Description of corner evidence found and/or method applied in restoring or reestablishing corner:

H-4

5

6

SET AT COMPUTED INTERSECTION
OF 1/4 LINES.

SET BY STANDARD SURVEY
PROCEDURE FOR SUBDIVISION OF A
SECTION.

SET BY STANDARD SURVEY
PROCEDURE FOR SUBDIVISION OF A
SECTION.

C. Description of monument for corner and accessories established to perpetuate locating the position of the corner:

H-4

5

6

CENTER OF SEC. 10
DNR MON.


N1/8 COR. ON N-S 1/4 LINE
5/8" BAR W/CAP

CENTER OF NE1/4 SEC. 10
5/8" BAR W/CAP

MAPLE 6" S28W 24.1 FT.
CEDAR 12" S56E 37.1 FT.
ASH 10" N73E 37.5 FT.
R.R. SPIKE N14E 42.2 FT.
CENTERLINE OF N-S ROAD IS EAST
12 FEET.

R.PINE 10" S75W 13.1 FT.
R.PINE 10" N26W 10.1 FT.
R.PINE 14" N79E 37.8 FT.
CENTERLINE OF N-S ROAD IS EAST
19 FEET.

ASH 6" N52E 8.4 FT.
SPRUCE 7" SOUTH 17.0 FT.
SPRUCE 3" N67W 16.5 FT.
OLD PROP. COR. S52E 4.2 FT.

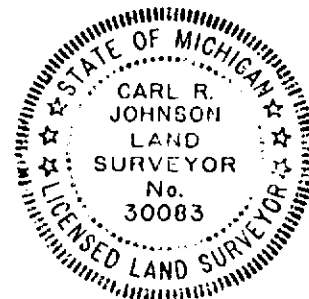

Signed by

Carl R. Johnson

Date

3/17/92

Surveyor's Michigan License No.

30083