

LAND CORNER RECORDATION CERTIFICATE
Filing Requirement of Act 74, Mich. PA 1970

For Corners In: _____
Montmorency _____ Located In _____ Corner Code # _____
(County)

1. Public Land Survey	T	32N	R	4E	C-1		
	T		R				
2. Property Controlling in Section	S	6	T	32N	R	4E	7
	S		T		R		
3. Miscellaneous Property in Section	S		T		R		
	S		T		R		


4. Lot No: _____ Recorded Plat: _____

5. Private Claims: _____

I, Carl T. Kiiskila, in a field survey on August 20, 2001 do hereby state that under requirements of PA 74, Michigan PA of 1970, the corner points mentioned in lines 1 and 2 above were in conformance with regulations and rules therefore as required in the current manual of survey instructions of the United States Department of the Interior, Bureau of Land Management or by a decree of a Court of Law and/or that the corner points mentioned in lines 3, 4 and 5 above were in conformance with the rules of the Michigan Board of Land Surveyors or by a Decree of a Court of Law; established, re-established, monumented, recovered, found as expressed below:

NOTE: Not more than 2 corners, all in the same town and range, may be recorded on this certificate.

Register of Deeds Stamp & File Number

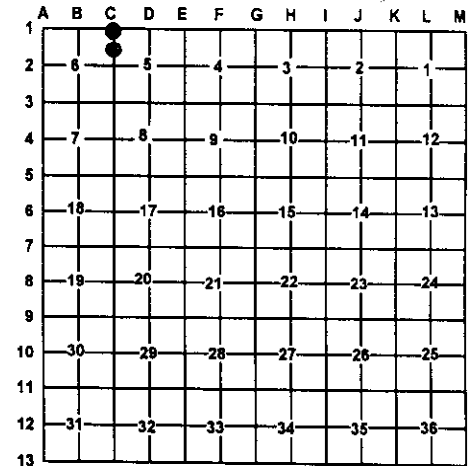

A. Description of original monument and accessories and/or subsequent restoration:

C-1 G.L.O. John Hodson D.S. 1840
Set post corner section 31 and 32 in swamp
Wit: Tamarack 12 N70°W 10 links
Tamarack 10 N28°E 9 links

7- This corner position was not established during the original government survey.

Jashiah Knauer D.S. 1856 Remeasured West on North line of section 6

C-13 T.33N.,R.4E. Pg. 660 Presque Isle County land corner records (Delmer E. Porter P.S. #15410 April, 1985). Set corner by proportionate measurement.

C-13 T.33N.,R.4E. Pg. 717 Presque Isle County land corner records (Ronald Bisher P.S. #22428 MAY 1986). Found original stake point and 1 O.B.T. Stump set ½" rod.

Wit: N27°W 7.44' 6" Spruce
S32°W 10.44' 6" Tamarack
S46°E 14.77' 4" Cedar

B. Description of corner evidence found and/or method applies in restoring or re-establishing corner:

C-1 Found ½" capped iron rod by P.S. #22428 Ronald Bisher.

7- Established the Southeast corner of the Northeast quarter of the Northeast quarter of section 6 as per B.L.M. instructions for the subdivision of a section.

C. Description of monument for corner and accessories established to perpetuate locating the position of the corner:

C-1 Set D.N.R. monument over found ½" iron rod
Wit: 6" Cedar S68°E 14.80'
5" Spruce S23°W 10.87'
7" Tamarack N82°W 10.23'
6" Spruce N10°W 17.86'
9" Spruce N29°W 7.80'
Carsonite Post North 1'±
Fd. ½" rod with P.S. cap #15410 S39°E 12.92'

7- 5/8" X 32" rerod with P.S. cap #33981
Wit: 5" Cedar South 7.97'
8" Cedar N64°E 24.49'
4" Cedar N47°W 10.88'
14" White Pine S69°W 37.46'
Carsonite Post North 1'±

Signed by: _____

Carl T. Kiiskila

Date: _____

1-10-02

Surveyor's Michigan License No.: _____ 33981

