

SURVEY &  
REMONUMENTATION

APR 24 1995

COMMISSION

For corners in

1994 NEWAYGO COUNTY REMONUMENTATION PROJECT  
LAND CORNER RECORDATION CERTIFICATE

Filing Requirement of Act 74, Mich. P.A. 1970

VOL 001 PAGE 90

<u>Newaygo</u> <small>(County)</small>	Located In:	Corner Code #
1. Public Land Survey	T <u>12N</u> R <u>12W</u>	K-3
	T _____ R _____	_____
	T _____ R _____	_____
	T _____ R _____	_____
2. Property Controlling in Section	S _____ T _____ R _____	_____
	S _____ T _____ R _____	_____
3. Miscellaneous Property in Sec.	S _____ T _____ R _____	_____
	S _____ T _____ R _____	_____
4. Lot No. _____, Recorded Plat _____		
5. Private Claims _____		

NEWAYGO COUNTY  
REGISTER OF DEEDS  
MARLENE TOOGOOD

'95 MAR 14 PM 3 53

*Marlene Toogood*  
Register of Deeds Stamp & File Number

I, Norman L. Ochs, in a field survey on September 28, 19 94  
do hereby certify that under requirements of P.A. 74, Michigan P.A. of 1970, the corner points mentioned  
in lines 1 and 2 above were in conformance with regulations and rules therefore as required in the  
current manual of survey instructions of the United States Department of the Interior, Bureau of Land  
Management or by a decree of a Court of Law and/or that the corner points mentioned in lines 3, 4 and 5  
above were in conformance with the rules of the Michigan Board of Land Surveyors or by a Decree of a  
Court of Law; established, re-established, monumented, re-monumented, recovered, found as  
expressed below:

NOTE: Not more than 4 corners, all in the same town and range, may be recorded  
on this certificate.

NE. Cor. Section 11, Brooks Twp., Newaygo County, Michigan

A. Description of original monument and accessories and/or subsequent restoration:

G.L.O. J.H. MULLETT. 183's Post in Mound	Patrick A. Salisbury R.L.S. #13594 T. Pole N30°W 68.83' #1 20" Cherry S80°E 50.33' #2 20" Tw. Cherry N30°E 100.78' #3	October 3, 1970 Set Conc. Monument Measured 5295.23 feet from the NE. Cor. to the NW. Cor. of Sec. 11. Measured 5288.55 feet from NW. Cor. to the NE. Cor. of Sec 12. Measured 5295.90 feet from the SE. Cor. to the NE. Cor. of Sec. 2. Measured 5302.50 feet from the NE. Cor. to the SE. Cor. of Sec. 11.
---	--	--

Old Consumers Power Co. Witness Sheets  
(Undated)  
Angle Iron

OVER----->

B. Description of corner evidence found and/or method applied in restoring or reestablishing corner:

In Sept. 1994, I, Norman L. Ochs, found Patrick A. Salisbury's Concrete Monument. I, measured 2647.56 feet  
from the N. 1/4 Cor. to the NE. Cor. of Sec. 11. I, also checked distances to 1/8 line fences East and  
West, these fit within a foot +- of the 1/2 mile distance. I, also looked for evidence of the C.P. Co. Angle  
Iron in the road intersection. Finding no contrary evidence, I accepted Patrick A. Salisbury's position based on  
his location in the occupied centerline of roads, and Condition of recorded witnesses are: #1 Gone, #2  
Thru #5 Good Condition.

C. Description of monument for corner and accessories established to perpetuate locating the position of the corner:

Removed Concrete Monument and replaced with a 4" Dia. Harrison Cast Iron Monument 20" long marked County  
Surveyor in the exact location, as a substantial marker for the section corner and is accepted as a careful  
and faithful reestablishment of the original corner.


24" Cherry N30°E 100.87' Spike on the West side of tree #3  
38" Cherry S78°E 51.39' Found spike on the West side of tree #2  
1/2" Rod and Cap (#21272) S45°E 46.83' #5  
Top Centerline of Telephone Riser N36°W 69.67' #4  
Centerline of Road going West is 12 North  
Centerline of North and South Road 3' East

Signed by Norman L. Ochs  
Surveyor's Michigan License No. #22439

Date

November 3, 1994

Accepted by Peer Review Group on November 3, 1994  
Norman L. Ochs, County Representative

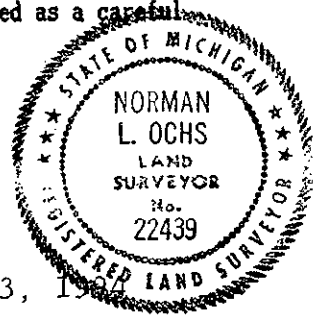

A. Description.... (Continued)

Newaygo Engineering and Survey Co.

June 20, 1986

Found Concrete Monument

20"-14" Tw. Cherry N30°E 100.78' #3

24" Cherry S80°E 51.42' #2

Top of East Telephone Riser N45°W 69.46' #4

Measured 2640.17 feet from the NW. Cor. to the W. 1/4 Cor. of Sec. 12. Measured 2647.26 feet from the NE. Cor. to the N. 1/4 Cor. of Sec. 11. Measured 2651.34 feet from the SW. Cor. to the W. 1/4 Cor. of Sec. 1. Measured 2644.26 feet from the SW. Cor. to the S. 1/4 Cor. of Sec. 1.

William Fries Jr. R.L.S. #30389 L.C.R.C. #777

July 1, 1987 Found Concrete Monument

18" Cherry AZ23° 100.78' #3

38" Cherry AZ102° 51.29' #2

1/2" Iron W/cap #21272 AZ135° 46.64' #5

Centerline Telephone Riser AZ324° 69.40' #4

Charles E. Fricke R.L.S. #21781

April 20, 1990 Recorded in Liber 351, Page 3211

18 Cherry N23°E 100.78' #3

38" Cherry S78°E 51.29' #2

Property Corner S45°E 46.64' #5

M.B.T. Telephone Riser N36°W 69.40' #4