

COMMISSION

LAND CORNER RECORDATION CERTIFICATE

Filing Requirement of Act 74, Mich. P.A. 1970 '94 JAN 21 PM 3 25

For corners in

Newaygo

(County)

Located In:

Corner Code ##

1. Public Land Survey

T 13N R 14W

A-1

2. Property Controlling  
in Section

S T R

3. Miscellaneous  
Property in Sec.

S T R

4. Lot No. , Recorded Plat

5. Private Claims

Marlene Toogood

VOL 001 PAGE 17

Register of Deeds Stamp & File Number

I, Norman L. Ochs, in a field survey on December 15, 1993

do hereby certify that under requirements of P.A. 74, Michigan P.A. of 1970, the corner points mentioned in lines 1 and 2 above were in conformance with regulations and rules therefore as required in the current manual of survey instructions of the United States Department of the Interior, Bureau of Land Management or by a decree of a Court of Law and/or that the corner points mentioned in lines 3, 4 and 5 above were in conformance with the rules of the Michigan Board of Land Surveyors or by a Decree of a Court of Law; established, re-established, monumented, re-monumented, recovered, found as expressed below:

NOTE: Not more than 4 corners, all in the same town and range, may be recorded on this certificate.

NW. Corner, Section 6, Dayton Twp., Newaygo Co., MI

A. Description of original monument and accessories and/or subsequent restoration:

G.L.O. Mullett and Brookfield 1837; Sept. 4, 1935  
 18" Beech N10°E 42 lks. (27.72') #1 Highway Dept.  
 12" Beech S26°W 48 lks. (31.68') #2 3/4" Gas Pipe

Lyle Shepherd's Witness Book

R.L.S. #503

26" Elm N56°E 42.7' #3

26" Elm N57°E 42.32' #3  
 12" Walnut S58°E 72.90' #4  
 14" Walnut S42°E 49.20' #5

N.C.R.C. Sheet  
 1 1/4" Gas Pipe  
 30" Elm N56°E 42.  
 #3  
 12" Walnut S45°E  
 49.3' #5

SEE OVER-----

B. Description of corner evidence found and/or method applied in restoring or reestablishing corner:

In 1935 the Highway Dept. found a 3/4" Gas Pipe. In 1954 Ralph A. Smith found a 1 1/4" Pipe. In 1963 Ralph A. Smith did a section break of Sec. 31, Denver Twp. Smith measured 2695.75 feet from the Sw. Corner to the S. 1/4 Corner and measure 2642.36 feet from the SW. Corner (Common Corner) to the W. 1/4 Corner of said section. In 1971 Newaygo Engineering and Survey Co. resurveyed Sec. 31, Denver Twp. They measured 2641.30 feet from the SW. Corner (Common Corner) to the S. 1/4 Corner to the S. 1/4 Corner of said section. In 1978 Newaygo Engineering and Survey Co. did a section break of Sec. 6, Dayton Twp. They measured 2678.12 feet from the NW. Corner of the N. 1/4 Corner and measured 2619.31 feet from the NW. Corner to the W. 1/4 Corner of said section. They found a 3/4" Pipe in Monument Box that was a foot West of the centerline of M-82 and is in the centerline of the East and West Road. In 1993 William Fries Jr. found a 3/4" Pipe in a monumer box that was 2 feet Westerly of the centerline of the North and South Roadway

SEE OVER-----

C. Description of monument for corner and accessories established to perpetuate locating the position of the corner:

Accepted 4" Harrison Cast Iron Monument as a substantial marker for the section corner and is accepted as a careful and faithful reestablishment of the original corner.

Guy Pole N14°E 119.68' Spike in NW. side of Pole #9  
 27" Spruce S19°E 124.75' Spike in NW. side of tree #10  
 P. Pole S54°W 90.01' Spike in SE. side of pole #11  
 Telephone Pole S55°W 57.36' Spike in NW. side of Pole

Signed by

Norman L. Ochs


Date December 29, 1993

Surveyor's Michigan License No.

22439

Approved by Peer Group December 29, 1993

Norman L. Ochs, County Representative

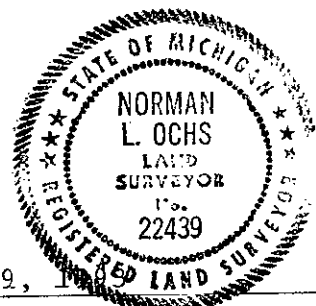

A. Continued.....  
Ralph A. Smith R.L.S. #3421  
March 3, 1954  
1 1/4" Pipe found  
30" Elm N56°E 42.5' #3  
12" Walnut S45°E 49.30' #5

June 27, 1978  
Newaygo Engineering and Survey Co.  
Found 3/4" Pipe in Monument Box  
8"-8"-8" Tri Walnut N65°E 39.93' #6  
Telephone Pole S16°W 57.01' #7  
Telephone Pole S46°E 62.24' #8

1993 William Fries, Jr.  
Found 3/4" Pipe  
Guy Pole AZ 14° 119.68' #9  
27" Spruce AZ 161° 124.75' #10  
P. Pole AZ 216° 90.01' #11  
8" Maple AZ 299° 91.30' #12

B. Continued.....  
Williams and Works did a section break of Sec. 1, Greenwood Twp., Oceana County, Michigan. They measured 2620.04 feet from the NE. Corner (Common Corner) to the E. 1/4 Corner and measured 2624.25 feet from the NE. (Common Corner) Corner to the N. 1/4 Corner of said section. Patrick A. Salisbury did a section break of Sec. 36, Newfield Twp., Oceana County, Michigan. Salisbury measured 2635.50 feet from the SE. Corner (Common Corner) to the S. 1/4 Corner and measured 2642.36 feet from the SE. Corner (Common Corner) to the E. 1/4 Corner of said section.  
On Dec. 15, 1993. I, Norman L. Ochs, found a 3/4" Pipe in Monument Box. Replaced (in the exact location) with a 4" Harrison Cast Iron Monument in Monument Box.

Condition of recorded witnesses is; #1 and #2 Gone #3 Good Condition #4 Gone  
#5 Good Condition #6 thru #8 Gone #9 thru #11 Good Condition #12 Gone