

MAR 19 1998

SECTION

1997 Newaygo County Remonumentation Project

LAND CORNER RECORDATION CERTIFICATE
FILING REQUIREMENT of Act 74, Mich. P.A. 1970NEWAYGO COUNTY
REGISTER OF DEEDS
LINDA M. BROWN

'98 MAR 6 PM 12 3

For corners in
Newaygo
(County)

Located in:

Corner Code #

Linda M. Brown

1. Public Land Survey

T 14N R 13W

E-7

T R

T R

T R

2. Property Controlling
in Section

S T R

S T R

3. Miscellaneous
Property in Sec.

S T R

S T R

VOL. 2

106

Register of Deeds Stamp & File Number

4. Lot No. _____, Recorded Plat _____
5. Private Claims _____

I, Norman L. Ochs, in a field survey on November 1, 19 97, do hereby certify that under requirements of P. A. 74, Michigan P.A. of 1970, the corner points mentioned in lines 1 and 2 above were in conformance with regulations and rules therefore as required in the current manual of survey instructions of the United States Department of the Interior, Bureau of Land Management or by a decree of a Court of Law and/or that the corner points mentioned in lines 3, 4 and 5 above were in conformance with the rules of the Michigan Board of Land Surveyors or by a Decree of a Court of Law, established, re-established, monumented, re-monumented, recovered, found as expressed below:

Note: Not more than 4 corners, all in the same town and range, may be recorded on this certificate.

Northwest Corner, Section 21, Lincoln Township, Newaygo County, Michigan.

	A	B	C	D	E	F	G	H	I	J	K	L	M
1													
2	6		5		4		3		2		1		
3													
4	7		8		9		10		11		12		
5													
6	18		17		16		15		14		13		
7													
8	19		20		21		22		23		24		
9													
10	30		29		28		27		26		25		
11													
12	31		32		33		34		35		36		
13													

A. DESCRIPTION OF ORIGINAL MONUMENT AND ACCESSORIES AND/OR SUBSEQUENT RESTORATION:

G.L.O. Milton Nye Resurvey 1856
26" White Pine S32°W 62 Links (40.92') #1
14" Beech N69°E 82 Links (54.12') #2

William M. Jacques (County Surveyor)
June 20, 1903 Book A Page 383
Set new stake
Old bearing in good condition

William M. Jacques (County Surveyor)
Book 23 Page 4 1907
East One Quarter Corner, Section 20, South
39.83 Chains (2628.78') #3
North One Quarter Corner, Section 20, West
39.16½ Chains (2584.89') #4

Robert A. Griffin R.L.S. #13584
1973 Set 1" Pipe
18" White Oak N25°W 6.12' #5
12"-10"-8" Red Oak S10°E 18.00' #6
12"-10" Triple Red Oak West 13.66' #7

OVER ↙

B. DESCRIPTION OF CORNER EVIDENCE FOUND AND/OR METHOD APPLIED IN RESTORING OR REESTABLISHING CORNER:

Found 4" diameter Harrison cast iron monument with concrete blocks around it at point of intersection of road going East and North. The condition of the recorded witnesses are: #1 and #2 gone, #3 and #4 did not measure, #5 thru #8 good condition.

C. DESCRIPTION OF MONUMENT FOR CORNER AND ACCESSORIES ESTABLISHED TO PERPETUATE LOCATING THE POSITION OF THE CORNER:

Accepted 4" diameter Harrison cast iron monument 36" long marked "County Surveyor" as a substantial marker for the section corner and is accepted as a careful and faithful reestablishment of the original corner.

18" White Oak N19°W 6.12' Found spike and brass washer in East side of tree. #5
18"-18"-12" Red Oak S02°E 18.00' Found spike and brass washer in East side of tree. #6
18"-18"-14" Red Oak West 13.56' Found spike and brass washer in South side of tree. #7
4" Ash N80°E 21.46' Set spike and brass washer in South side of tree. #8

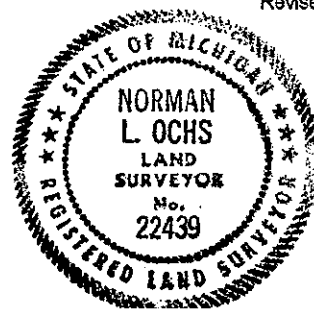
Signed by Norman L. Ochs Date November 10, 1997

Norman L. Ochs

Surveyor's Michigan License No. 22439

Form approved by Michigan State Board of Land Surveyors, Jan 28, 1971
Revised May 14, 1975
Revised Jan., 1983

Approved by Peer Review Group on November 11, 1997
Norman L. Ochs, County Representative.

N.L.O.

A. Description (cont.)

Newaygo Engineering and Survey Company
Drawing Number 80023B March 14, 1980
Found 1" Pipe Pipe is 1 foot above ground.
18" White Oak N25°W 6.12' #5
12"-10"-8" Triple Red Oak S10°E 18.00' #6
12"-12"-10" Triple Red Oak West 13.66' #7

Newaygo Engineering and Survey Company
Drawing Number 83038B March 23, 1983
Found 1" Pipe
18" White Oak N25°W 6.12' #5
10" Triple Red Oak S10°E 18.00' #6
10" Triple Red Oak West 13.66' #7

Newaygo Engineering and Survey Company
December 31, 1986 LCRC #801
Found 1" Pipe as set by Robert A. Griffin. Removed and set a 4" diameter Harrison cast iron monument 36" long marked
"County Surveyor".
18" White Oak N25°W 6.12' #5
12"-10"-8" Triple Red Oak S10°E 18.00' #6
12"-12"-10" Triple Red Oak West 13.66' #7
3" Ash N85°E 21.49' #8