

SURVEY &
REMONUMENTATION

APR 24 1995

1994 NEWAYGO COUNTY REMONUMENTATION PROJECT

COMMISSION

LAND CORNER RECORDATION CERTIFICATE

Filing Requirement of Act 74, Mich. P.A. 1970

VOL 001 PAGE 125

For corners in

Newaygo
(County)

Located In:

Corner Code #

1. Public Land Survey

T 14N R 13W

I-5

T R

T R

T R

T R

2. Property Controlling
in Section

S T R

S T R

3. Miscellaneous
Property in Sec.

S T R

S T R

NEWAYGO COUNTY
REGISTER OF DEEDS
MARLENE TOOGOOD

'95 MAR 14 PM 3 57

Marlene Toogood
Register of Deeds Stamp & File Number

4. Lot No. , Recorded Plat

5. Private Claims

I, Norman L. Ochs, in a field survey on November 21, 19 94,
do hereby certify that under requirements of P.A. 74, Michigan P.A. of 1970, the corner points mentioned
in lines 1 and 2 above were in conformance with regulations and rules therefore as required in the
current manual of survey instructions of the United States Department of the Interior, Bureau of Land
Management or by a decree of a Court of Law and/or that the corner points mentioned in lines 3, 4 and 5
above were in conformance with the rules of the Michigan Board of Land Surveyors or by a Decree of a
Court of Law; established, re-established, monumented, re-monumented, recovered, found as
expressed below:

NOTE: Not more than 4 corners, all in the same town and range, may be recorded
on this certificate.

S.E. Corner, Section 10, Lincoln Twp., Newaygo Co., MI

A. Description of original monument and accessories and/or subsequent restoration:

G.L.O. Milton Nye 1856

6" Beech N69°E 25 lks. (16.5') #1

12" Beech S23 1/2°W 35 lks. (23.1') #2

Robert A. Griffin R.L.S. #13584 1978

Found Rail Road Rail

5"-7" Tw. Beech N75°E 20.87' #3

5" Maple N59°W 22.64' #4

Robert A. Griffin R.L.S. #13584 L.C.R.C. #569 October 13, 1983

Found Rail Road Rail and set a 5" x 36" Conc. Monument with brass cap

P. Pole S53°E 27.47' #5 12" R. Maple S83°W 42.89' #7

7" W. Oak S37°W 37.60' #6 4"x4" Pine Post West 33.01' #8

Measured 2542.12 feet from the N.E. Cor. to the N. 1/4 Cor. of Sec. 15 and
measured 2657.86 feet from the N.E. Cor. to the E. 1/4 Cor. of Sec. 15.

OVER----->

B. Description of corner evidence found and/or method applied in restoring or reestablishing corner:

Found Robert A. Griffin's 5"x36" Sq. Concrete Monument with brass cap. Centerline of the North and South road is 5
feet East and the condition of the recorded witnesses are: #1 and #2 Gone, #3 thru #8 Good Condition.

C. Description of monument for corner and accessories established to perpetuate locating the position of the corner:

Accepted Robert A. Griffin's 5"x36" Concrete Monument with brass cap as a substantial marker for the section corner
and is accepted as a careful and faithful reestablishment of the original corner.

P. Pole S53°E 27.50' Spike in the S.W. side of pole #5


12" Maple S83°W 42.66' Spike in North side of tree #7

8" W. Oak S37°W 37.51' Spike in N.W. side of tree #6

8" Maple N55°W 22.66' Spike in North side of tree #4

5"-4" Tw. Beech (Dead) N80°E 21.36' Spike in South side of tree #3

4"x4" Pine Post West 33.01' Nail is South side of post #8

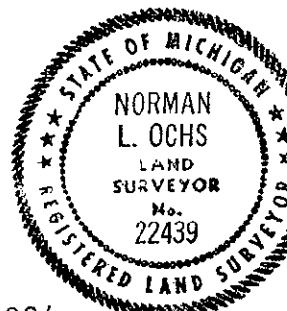

Signed by

Norman L. Ochs

Date November 22, 1994

Surveyor's Michigan License No. #22439

Approved by Peer Review Group on December 1, 1994

Norman L. Ochs, County Representative. *N.L.O.*

A. Description.....(Continued)

Robert L. Wetherell R.L.S. #24264

Measured 2665.29 feet from the W. 1/4 Corner to the S.W. Corner of Sec. 11 and measured 2554.84 feet from the S.W. Cor. to the S. 1/4 Cor. of Sec. 11.