

SURVEY & REMONUMENTATION

APR 02 1998

1997 Newaygo County Remonumentation Project

LAND CORNER RECORDATION CERTIFICATE
FILING REQUIREMENT of Act 74, Mich. P.A. 1970

NEWAYGO COUNTY
REGISTER OF DEEDS
LINDA M. BROWN

'98 MAR 6 PM 12 38

Linda M. Brown

For corner in
SECTION
Newaygo
(County)

Located in:

Corner Code #

1. Public Land Survey

T 16N R 12W

G-5

VOL. 2

146

2. Property Controlling
in Section

S T R

3. Miscellaneous
Property in Sec.

S T R

4. Lot No. , Recorded Plat

5. Private Claims

Register of Deeds Stamp & File Number

I, Norman L. Ochs, in a field survey on August 8, 1997, do hereby certify that under requirements of P. A. 74, Michigan P.A. of 1970, the corner points mentioned in lines 1 and 2 above were in conformance with regulations and rules therefore as required in the current manual of survey instructions of the United States Department of the Interior, Bureau of Land Management or by a decree of a Court of Law and/or that the corner points mentioned in lines 3, 4 and 5 above were in conformance with the rules of the Michigan Board of Land Surveyors or by a Decree of a Court of Law; established, re-established, monumented, re-monumented, recovered, found as expressed below:

Note: Not more than 4 corners, all in the same town and range, may be recorded on this certificate.

Northwest Corner, Section 15, Home Township, Newaygo County, Michigan

	A	B	C	D	E	F	G	H	I	J	K	L	M
1													
2	6		5		4		3		2		1		
3													
4	7		8		9		10		11		12		
5													
6	18		17		16		15		14		13		
7													
8	19		20		21		22		23		24		
9													
10	30		29		28		27		26		25		
11													
12	31		32		33		34		35		36		
13													

A. DESCRIPTION OF ORIGINAL MONUMENT AND ACCESSORIES AND/OR SUBSEQUENT RESTORATION:

G.L.O. Milton Nye Resurvey 1856
11" White Birch S44°W 22 Links (14.52')#1
11" Hemlock N80°E 23 Links (15.18')#2

Delos G. Anderson (County Surveyor)
Book A Page 254 May 8 and 9, 1899
Old corner

George H. Johnson R.L.S. #504
Iron Undated Survey
3" Pine Stump N77°E 97 Links (64.02')#2
11" Birch S44°W 22 Links (14.52')#3
11" Hemlock N80°E 23 Links (15.18')#4

William M. Jacques (County Surveyor)
Book A Page 377 April 7, 1903
The original bearing's were still plain. Set a cast iron sleigh shoe for corner post.

Lyle S. Shepherd R.L.S. #503
Witness Book Number 1 Page 141
Steel Shaft
36" Pine Stump N70°±E 47.2' #5
Corner Fence Post N45°±W 48.5' #6
Corner Fence Post S45°±W 47.2' #7

OVER

B. DESCRIPTION OF CORNER EVIDENCE FOUND AND/OR METHOD APPLIED IN RESTORING OR REESTABLISHING CORNER:

Found R.A.G. monument and the centerline of the North and South gravel road is 4 feet West and the trail road going East is 4 feet North and the centerline of the trail road going West is 3 feet South and the condition of the recorded witnesses are: #1 thru #7 gone, #8 thru #12 good condition.

C. DESCRIPTION OF MONUMENT FOR CORNER AND ACCESSORIES ESTABLISHED TO PERPETUATE LOCATING THE POSITION OF THE CORNER:

Accepted R.A.G. monument as a substantial marker for the section corner and is accepted as a careful and faithful reestablishment of the original corner.

Power Pole S16°E 90.04' Found nail and tag in Northeast side of pole. #8
Forest Post N45°W 46.82' Found nail and tag in Southwest side of post. #9
"X" Stone S40°W 59.10' "X" on top North side of big stone. #10
16" Jack Pine N49°W 64.99' Found nail and brass tag in Southwesterly side of tree.
Set new brass washer and nail above it. #11
16" Cherry S65°E 81.39' Set spike and brass washer with blaze in North side of tree. #12
5" Cherry N60°E 72.85' Set spike and tag in Northeast side of tree.

Signed by Norman L. Ochs Date September 8, 1997

Norman L. Ochs

Surveyor's Michigan License No. 22439

Form approved by Michigan State Board of Land Surveyors, Jan 28, 1971


Revised May 14, 1975

Revised Jan., 1983

Approved by Peer Review Group on December 18, 1997

Norman L. Ochs, County Representative.

N.L.O.

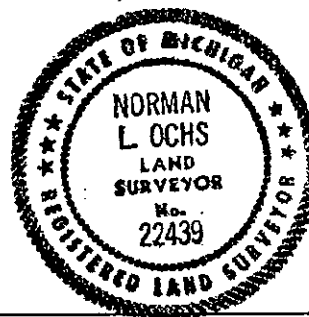

APR 02 1998

A. Description (cont.)

Newaygo County Road Commission Sheet

1966 Steel Shaft

Fence Corner S46°W 47.6' #7

Power Pole S20°E 89.5' #8

Forest Post N46°E 43.9' #9

"X" Stone S30°W 59.1' #10

Fence Corner N45°W 48.8' #6

Clinton E. Cole R.L.S. #17615

April 12, 1974 File Number 2146-74

Power Pole S16°E 90.04' #8

10" Jack Pine N49°W 65.04' #11

8" Cherry S59°E 81.39' #12

Robert A. Griffin R.L.S. #13584

June 19, 1974 LCRC #325

Found 5/8" Steel Shaft in the intersection of roads North, South, East and West. Found two previous witnesses.

Set 5" square X 36" Concrete monument

Fence Corner S46°W 47.6' #7

U.S.F.S. Post N46°E 43.9' #9

"X" cut in top stone 3' X 4' X 2.5' S30°W 59.1' #10

Power Pole S16°E 90.04' #8