

**SURVEY & REMONUMENTATION**

LIBER 19350P0867

JA-599001667

MAR 11 1999

**LAND CORNER RECORDATION CERTIFICATE**  
Filing Requirement of Act 74, Mich. P.A. 1970

\$ 7.00 MISCELLANEOUS RECORDING  
\$ 2.00 REMONUMENTATION  
JAN 99 8:23 A.M. RECEIPT PAID  
PAID RECORDED - OAKLAND COUNTY  
G. WILLIAM CADDELL  
CLERK/REGISTER OF DEEDS

For corners in SECTION

Oakland (County)	Located in: Lyon Township	Corner Code #
1. Public Land Survey	T <u>1N</u> R <u>7E</u>	<u>A-1</u>
	T _____ R _____	_____
	T _____ R _____	_____
	T _____ R _____	_____
2. Property Controlling in Section	S _____ T _____ R _____	_____
	S _____ T _____ R _____	_____
3. Miscellaneous Property in Sec.	S _____ T _____ R _____	_____
	S _____ T _____ R _____	_____
4. Lot No. _____, Recorded Plat _____		
5. Private Claims _____		

Compliance with  
ACT 345, P.A. 1990  
APPROVED ON: 12-21-98 SS  
OAKLAND COUNTY REMONUMENTATION  
PEER GROUP COMMITTEE  
Register of Deeds Stamp & File Number

I, Randy Kolehouse, in a field survey on December 21 19 98, do hereby certify that under requirements of P.A. 74 Michigan P.A. of 1970, the corner points mentioned in lines 1 and 2 above were in conformance with regulations and rules therefore as required in the current manual of survey instructions of the United States Department of the interior, Bureau of Land Management or by a decree of a Court of Law and/or that the corner points mentioned in lines 3, 4 and 5 above were in conformance with the rules of the Michigan Board of Land Surveyors or by a Decree of a Court of Law; established, re-established, monumented, re-monumented, recovered, found as expressed below:

**NOTE: Not more than 4 corners, all in the same town and range, may be recorded on this certificate.**

A.	Description of original monument and accessories and/or subsequent restoration:
A-1	1816 Holmes G.L.O. Set Post N/A N/A O.C. Tax Maps N/A

Records indicate this corner is not common with M-1, T1N, R6E and M-13, T2N, R6E, but is common with A-13, T2N, R7E

B. Description of corner evidence found and/or method applied in restoring or reestablishing corner:

A-1 Found no information on record for this corner. Reestablished corner on the northerly extension of a line between M-1, T1N, R6E, and A-2, T1N, R7E, at the intersection of a line extended West using C-1 and D-1, T1N, R7E. This point is 356.97' North of M-1, T1N, R6E and falls in a golf course.

Measure South 3324.9' to A-2  
Measure East 1540.9' to B-1  
Measure South 356.97' to M-1, T1N, R6E


C. Description of monument for corner and accessories established to perpetuate locating the position of the corner:

A-1 Set a capped rebar with a 5/8" x 24" rebar with brass cap stamped "Oakland County Remonumentation P.S. #25854."

PK Nail & Oakland Co. Remonumentation Tag in E Side 36" Oak S 08° E 213.06'  
PK Nail & Oakland Co. Remonumentation Tag in SW Side 28" Oak S 53° E 79.39'  
PK Nail & Oakland Co. Remonumentation Tag in SE Side 24" Oak N 54° E 89.04'  
PK Nail & Oakland Co. Remonumentation Tag in S Side 20" Oak N 62° W 182.75'  
Livingston County Monument S 00° E 356.97' ±  
No Occupation E-W

The selected location is accepted by the Contractor and is generally accepted by professional surveyors as the best available evidence of the position of the original corner.

Signed by Randy Kolehouse Date 12/28/98  
EARTH TECH  
Surveyor's Michigan License No. 25854

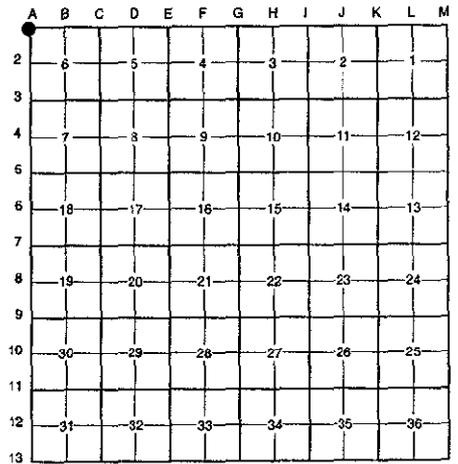

7.00 FILE  
2.00

