

LIBER 19296 PG 534

**LAND CORNER RECORDATION CERTIFICATE**  
**Filing Requirement of Act 74, Mich. P.A. 1970**

Located in: Lyon Township Corner Code #

1. Public Land Survey	T <u>1N</u>	R <u>7E</u>	<u>A-11</u>
	T _____	R _____	_____
	T _____	R _____	_____
	T _____	R _____	_____
2. Property Controlling in Section	S _____	T _____	R _____
	S _____	T _____	R _____
3. Miscellaneous Property in Sec.	S _____	T _____	R _____
	S _____	T _____	R _____

4. Lot No. \_\_\_\_\_, Recorded Plat \_\_\_\_\_  
5. Private Claims \_\_\_\_\_

I, Bruce Antcliff, in a field survey on July 22 19 98, do hereby certify that under requirements of P.A. 74 Michigan P.A. of 1970, the corner points mentioned in lines 1 and 2 above were in conformance with regulations and rules therefore as required in the current manual of survey instructions of the United States Department of the interior, Bureau of Land Management or by a decree of a Court of Law and/or that the corner points mentioned in lines 3, 4 and 5 above were in conformance with the rules of the Michigan Board of Land Surveyors or by a Decree of a Court of Law; established, re-established, monumented, re-monumented, recovered, found as expressed below:

**NOTE:** Not more than 4 corners, all in the same town and range, may be recorded on this certificate.

A. Description of original monument and accessories and/or subsequent restoration:

A-11	1816	Holmes	G.L.O.	Set Post
	1973	Oliver	L.C.R.C. L. 6084 P. 356	1 1/2" Iron Pipe
<i>(Continued on Back)</i>				

Records indicate this corner is not common with M-11, T1N, R6E.

B. Description of corner evidence found and/or method applied in restoring or reestablishing corner:

A-11 Found a capped iron ANB #21561 on the C/L of Nine Mile Road (bit.) running East, 19' South of the C/L of Nine Mile Road (gravel) running West, and on the C/L of Dixboro Road (gravel) running North and South. Found iron is on line between M-11 and M-12, T1N, R6E, and checks surveys and L.C.R.C.'s from 1987 to the present. Also checks the following witnesses:

L.C.R.C. L. 6084 P. 356 (m. 1973)  
N 15° W 133.4' Util. Pole (m. 133.67')  
S 11° E 165.5' Util. Pole (m. 164.92')  
S 45° E 46.6' I.P. (m. 46.60')

L.C.R.C. L. 13234 P. 052 (1991)  
 N 09° W 133.69' to PK Nail E Side of Pole (m. 133.67')  
 S 50° E 76.28' to 6 Penny Nail 8" Elm (m. 76.23')  
 S 66° W 38.97' to Top C/L CP Gas Pipeline Marker (m. 38.94')  
 S 08° E 164.80' to PK Nail W Side of Pole (m. 164.75')  
 N 01° E 41.91' to 3/4" Pipe with Cap in Mon. Box SE Cor. Sec. 25 T1N-R6E (m. 41.95')

Measure North 2645.0' to A-10 (Butterfield Survey (1978) = 2644.33')  
Measure South 2638.4' to A-12  
Measure East 1527.8' to B-11 (G.L.O. = 1535.16')  
Measure North 41.95' to M-11, T1N, R6E (G.L.O. = 118.14') (LSC#1760 = 41.80' to CL Mon. Box)

C. Description of monument for corner and accessories established to perpetuate locating the position of the corner:

A-11 Replaced the capped iron with a 5/8" x 24" rebar with brass cap stamped "Oakland County Remonumentation P.S. #25826."

PK Nail & Oakland Co. Remonumentation Tag in E Side P. Pole N 15° W 133.67'  
PK Nail & Oakland Co. Remonumentation Tag in W Side P. Pole S 11° E 164.75'  
PK Nail & Oakland Co. Remonumentation Tag in W'ly Side 8" Elm S 50° E 76.23'  
PK Nail & Oakland Co. Remonumentation Tag in S Side 24" Oak N 80° E 196.10'  
PK Nail & Oakland Co. Remonumentation Tag in W Side 6" x 6" Wood Post to Wood Walk Most S'ly Post N 23° E 62.3'  
W End N'ly CMP Culvert S 25° W 37.20'  
E End N'ly CMP Culvert S 27° E 47.75'  
Gas Main Sign Post S 80° E 38.94'  
SE Cor. Sec. 25 T1N, R6E to Brass Cap Stamped Livingston Co. N 01° E 41.95'



The selected location is accepted by the Contractor and is generally accepted by professional surveyors as the best available evidence of the position of the original corner.

Signed by Bruce Antcliff  
EARTH TECH

Date 12-10-98

Surveyor's Michigan License No. 25826

FORM APPROVED BY MICHIGAN STATE BOARD OF LAND SURVEYORS, JAN. 28, 1971  
REVISED MAY 14, 1975  
REVISED JAN. 1983

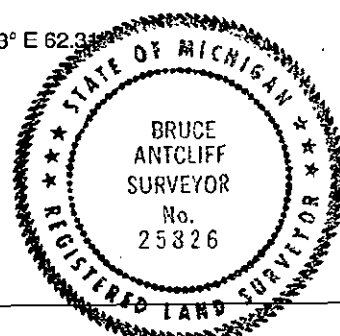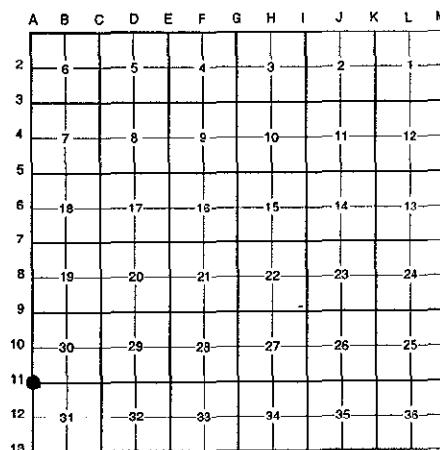

**SURVEY &  
REMONUMENTATION**

WAR 1.1. 1999

**SECTION**

**A. Description of original monument and accessories and/or subsequent restoration:**

A-11	1978	Butterfield	L.C.R.C. L. 7368 P. 326	1" Iron Pipe
	1978	Butterfield	Cert. Survey L. 7368 P. 320	Bent 1/2" Pipe
	1978	Butterfield	L.C.R.C. L.C.S. #1117	1" Iron Pipe
	1991	Butterfield	L.C.R.C. L. 13234 P. 052	2/3" Capped Iron
	1992	Butterfield	L.C.R.C. L.S.C. #1593 (Livingston)	3/4" Iron in Mon. Box
	1996	Hastings	L.C.R.C. L.S.C. #1760 (Livingston)	Iron Pipe in Mon. Box
	N/A	N/A	O.C. Tax Maps	N/A