

LIBER 21028. 605

25916

LAND CORNER RECORDATION CERTIFICATE Filing Requirement of Act 74, Mich. P.A. 1970

LIBER 21028 PAGE 605
\$9.00 MISC RECORDING
\$2.00 REMONUMENTATION
01/27/2000 08:21:22 A.M. RECEIPT# 666
PAID RECORDED - OAKLAND COUNTY
G. WILLIAM CADDELL, CLERK/REGISTER OF

For corners in

Oakland

(County)

Located In:

Corner Code #

1. Public Land Survey

T 2N R 7E

L-7

T R

T R

2. Property Controlling In Section

S

T R

S

T R

3. Miscellaneous Property In Sec.

S

T R

S

T R

SURVEY &
REMONUMENTATION

MAR 21 2000

SECTION

4. Lot No. , Recorded Plat

5. Private Claims

I, Grant J. Ward, R.L.S., in a field survey on September 14, 1999 do hereby state that under requirements of P.A. 74, Michigan P.A. of 1970, the corner points mentioned in lines 1 and 2 above were in conformance with regulations and rules therefore as required in the current manual of survey instructions of the United States Department of the Interior, Bureau of Land Management or by a decree of a Court of Law and /or that the corner points mentioned in lines 3, 4 and 5 above were in conformance with the rules of the Michigan Board of Land Surveyors or by a Decree of a Court of Law; established, re-established, monumented, recovered, found as expressed below:

NOTE: Not more than 2 corners, all in the same town and range, may be recorded on this certificate.

	A	B	C	D	E	F	G	H	I	J	K	L
1												
2	6			5			4		3		2	
3												
4	7			8			9		10		11	1
5												
6	18			17			16		15		14	1
7												
8	19			20			21		22		23	2
9												
10	30			29			28		27		26	2
11												
12	31			32			33		34		35	3
13												

A. Description of original monument and accessories and/or subsequent restoration:

L-7 Post, per G.L.O. Notes.

B. Description of corner evidence found and/or method applied in restoring or reestablishing corner:

L-7 North 1/4 Corner of Section 24, T. 2 N., R. 7 E.

Previously unrecorded.

This corner location is a careful and faithful reestablishment of the position of the Original Corner by single proportion measurement by the Contractor per the Government Instructions for a Lost or Obliterated Corner.

C. Description of monument for corner and accessories established to perpetuate locating the position of the corner:


L-7 Set Monument and Remonumentation Cap.

N 20° E 49.54' Set 60d Nail & Remonumentation Disc in East face of 6" Cedar.

N 60° E 22.06' Set 60d Nail & Remonumentation Disc in Southeast face of 4" Poplar.

N 80° E 22.19' Set 60d Nail & Remonumentation Disc in Northwest face of 6" Poplar.

S 70° W 22.26' Set 60d Nail & Remonumentation Disc in North face of 4" Elm.

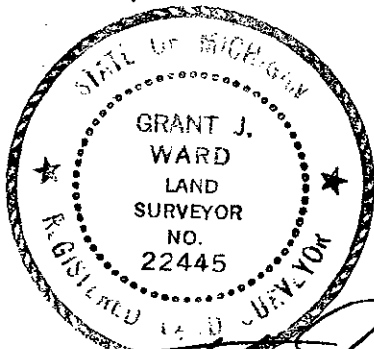

Signed by

Date September 15, 1999

Surveyor's Michigan License No. 22445

SEPTEMBER 15, 1999

Corner Code: L-7

DOSSIER FOR: THE SOUTH 1/4 CORNER OF SECTION 13, MILFORD TOWNSHIP,
T 2 N, R 7 E, OAKLAND COUNTY, MICHIGAN. Prepared under contract with the
County of Oakland Under Act 345 of the Public Acts of 1990.

HISTORY:

This Corner was originally set by the GLO half way between the Southwest and the Southeast Corners of Section 13, the County Surveyor Russel measured this mile. This Corner has not been recorded and other than the County Surveyor we have no surveys showing any distances to adjacent Corners.

COLLATERAL EVIDENCE:

We set a concrete monument and remonumentation cap midway and on line with the Southwest and the Southeast Corners of Section 13 per the Government Instructions for a lost Corner. This Corner lies in a swamp. There is no evidence of occupation in any direction from the Corner. We measured about 6 feet longer for the mile than the GLO and about 18 feet longer than the County Surveyor. We searched at least 50 feet in each direction for other stakes and found none that might represent the Corner.

SURVEYOR'S RECOMMENDATIONS:

This Corner location is a careful and faithful re-establishment of the position of the Original Corner by single proportion measurement by the Contractor per the Government Instructions for a Lost or Obliterated Corner. Therefore, I recommend that the Peer Review Group accept this Corner as monumented, with the references as shown on the enclosed form prepared according to Act 74 of the Public Acts of 1970.

Grant J. Ward, R.L.S.
License No. 22445

SURVEY &
REMONUMENTATION

MAR 21 2000

SECTION