

LAND CORNER RECORDATION CERTIFICATE
Filing Requirement of Act 74, Mich. P.A. 1970

LIBER 19827 PAGE 756
\$7.00 MISC RECORDING
\$2.00 REMONUMENTATION
04/13/1999 01:46:43 P.M. RECEIPT# 18471
PAID RECORDED - OAKLAND COUNTY
G. WILLIAM CADDELL, CLERK/REGISTER OF DEEDS

For corners in

Oakland

(County)

Located In: Pontiac Corner Code # G-2
Twp.

1. Public Land Survey

T 3N R 10E G-2T R T R T R

2. Property Controlling in Section

S T R S T R

3. Miscellaneous Property in Sec.

S T R S T R

SURVEY &
REMONUMENTATION

MAR 21 2000

Compliance with
ACT 345, P.A. 1990

APPROVED ON: 3-24-99 JS
OAKLAND COUNTY REMONUMENTATION
PEER GROUP COMMITTEE

Register of Deeds Stamp & File Number

4. Lot No. , Recorded Plat

SECTION

5. Private Claims

I, Raymond J. McCoy a field surveyor on Mar. 2, 19 99 do hereby state that under requirements of P.A. 74, Michigan P.A. of 1970, the corner points mentioned in lines 1 and 2 above were in conformance with regulations and rules therefore as required in the current manual of survey instructions of the United States Department of the Interior, Bureau of Land Management or by a decree of a Court of Law and /or that the corner points mentioned in lines 3, 4 and 5 above were in conformance with the rules of the Michigan Board of Land Surveyors or by a Decree of a Court of Law; established, re-established, monumented, recovered, found as expressed below:

NOTE: Not more than 2 corners, all in the same town and range, may be recorded on this certificate.

	A	B	C	D	E	F	G	H	I	J	K	L
1												
2		6		5		4	●	3		2		1
3												
4		7		8		9		10		11		12
5												
6		18		17		16		15		14		13
7												
8		19		20		21		22		23		24
9												
10		30		29		28		27		26		25
11												
12		31		32		33		34		35		36
13												

A. Description of original monument and accessories and/or subsequent restoration:

Wampler, D.S. Set Post

There are 3 L.C.R.C.'s recorded.

- 1) 1979- J. Emig, Found 1/2" iron bar in Lake Angelus Road. One witness remain
- 2) 1986- S. Sandomierski, Found 3/8" rerod. No witnesses remain.
- 3) 1990- K. Wilkerson. Found iron in MOn. Box. One witness remains.

B. Description of corner evidence found and/or method applied in restoring or reestablishing corner:

Found 1/2" iron in Monument Box centerline of Harmon Road. Recovered corner from remaining witnesses in above L.C.R.C.'s and from several Surveys. Validated corner with monumentation in "METRO NORTH TECHNOLOGY PARK"(L. 196, Pgs. 32-40) and by recorded distances measured to H-2, G-1, G-3.

State Plane Coordinates N 439126.3305
E13417600.1815

C. Description of monument for corner and accessories established to perpetuate locating the position of the corner:

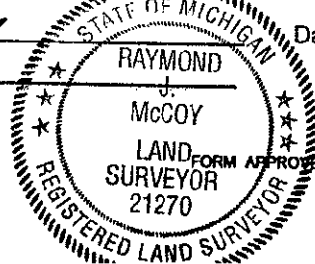
Replaced 1/2" iron with a 5/8"x24" iron rod with a 2" diameter brass disk stamped Oakland County Remonumentation P.S. #21270 in the existing Monument Box.

Witnesses:

- S 50° W, 34.40, Found chisel "x" in N.E. corner of Catch Basin Rim.
N 50° W, 36.12, Found chiseled "x" in S.E. corner of Catch Basin Rim.
N 10° E, 46.28' Set O.C.R.T. #21270 in W. Face of Power Pole.
Due South, 41.13' Set O.C.R.T. #21270 in W. Face of Power Pole.

THE SELECTED LOCATION IS ACCEPTED BY ME AND IS GENERALLY ACCEPTED BY PROFESSIONAL SURVEYORS AS THE BEST AVAILABLE EVIDENCE OF THE POSITION OF THE ORIGINAL CORNER

Signed by Raymond J. McCoy
Surveyor's Michigan License No. 21270

Date Mar. 30, 1999

FORM APPROVED BY MICHIGAN STATE BOARD OF PROFESSIONAL SURVEYORS, JAN. 28, 1971
REVISED MAY 14, 1975
REVISED JAN., 1983
REVISED OCT., 1995