

# LAND CORNER RECORDATION CERTIFICATE

Filing Requirement of Act 74, Mich. P.A. 1970 31115

For corners in

Oakland

(County)

Pontiac

Located In: Twp. Corner Code #

LIBER 21052 PAGE 167

\$7.00 MISC RECORDING

\$2.00 REMONUMENTATION

02/01/2000 09:59:02 A.M. RECEIPT# 7944

PAID RECORDED - OAKLAND COUNTY

G. WILLIAM CADDELL, CLERK/REGISTER OF DEEDS

1. Public Land Survey

T3N R10E H-11

T R

T R

T R

2. Property Controlling in Section

S T R

S T R

3. Miscellaneous Property in Sec.

S T R

S T R

4. Lot No. , Recorded Plat

5. Private Claims

Raymond J. McCoy

May 28 99

I, Raymond J. McCoy, in a field survey on May 28 99, 19 do hereby state that under requirements of P.A. 74, Michigan P.A. of 1970, the corner points mentioned in lines 1 and 2 above were in conformance with regulations and rules therefore as required in the current manual of survey instructions of the United States Department of the Interior, Bureau of Land Management or by a decree of a Court of Law and/or that the corner points mentioned in lines 3, 4 and 5 above were in conformance with the rules of the Michigan Board of Land Surveyors or by a Decree of a Court of Law; established, re-established, monumented, recovered, found as expressed below:

NOTE: Not more than 2 corners, all in the same town and range, may be recorded on this certificate.

	A	B	C	D	E	F	G	H	I	J	K	L	M
1													
2	6		5		4		3		2		1		
3													
4	7		8		9		10		11		12		
5													
6	18		17		16		15		14		13		
7													
8	19		20		21		22		23		24		
9													
10	30		29		28		27		26		25		
11													
12	31		32		33		34		35		36		
13													


A. Description of original monument and accessories and/or subsequent restoration:

1817 Post GLO

There are 2 LCRC's recorded for this corner.

1) 1984-Dely, L. 8764, Pg.836, 1/2" iron in Mon. Box, 3 remaining witnesses

2) 1990-Ward, L. 11318, Pg. 57, iron in Mon. Box, 3 remaining witnesses

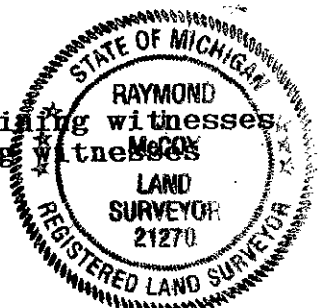

B. Description of corner evidence found and/or method applied in restoring or reestablishing corner:

Found 1/2" iron in Mon. Box, centerline of Auburn Rd., 67 ft. West of centerline of Bridge for Railroad. Recovered corner from remaining witnesses in Road Commission Records(1961 & 1962). Validated corner with matching closely the 1/2 mile distance(A/P#147) East to I-11. Also fit closely with monumentation found along the Northerly R/W line of Auburn Ave. as found in "HOMESTEAD PARK #1"(L.38, Pg.3, 1925).

State Plane Coordinates N 415594.2097  
E 13421387.9089

C. Description of monument for corner and accessories established to perpetuate locating the position of the corner:

Set 5/8"x24" iron rod with 2" diameter brass disk stamped Oakland County Remonumentation P.S. #21270 in the existing Monument Box.

Witnesses:

South, 47.53' Set OCRT East face of Power Pole

S 50° W, 85.31' Set OCRT in SE face of Power Pole

N 55° E, 27.95' Set chiseled "x" on W. rim of M.H.

S 80° E, 181.45' Set OCRT in NE face of Power Pole

THE SELECTED LOCATION IS ACCPETED BY ME AND IS GENERALLY ACCEPTED BY PROFESSIONAL SURVEYORS AS THE BEST AVAILABLE EVIDENCE OF THE POSITION OF THE ORIGINAL CORNER.

Signed by Raymond J. McCoy  
Surveyor's Michigan License No. 21270

Date 1-5-00