

MAY 24 2000

LIBER 19516PG267

SECTION

LAND CORNER RECORDATION CERTIFICATE  
Filing Requirement of Act 74, Mich. P.A. 1970

For corners in

<u>Oakland</u> (county)	Located In: Rose Township	Corner Code # A-3
1. Public Land Survey	T4N R7E	
	T R	
	T R	
	T R	
2. Property Controlling S	T R	
in Section S	T R	
3. Miscellaneous S	T R	
Property in Sec. S	T R	

\$9.00 MISC RECORDING  
\$2.00 REMONUMENTATION  
03/01/1999 02:59:15 P.M. RECEIPT# 4337  
PAID RECORDED - OAKLAND COUNTY  
G. WILLIAM CADDELL, CLERK/REGISTER OF DEEDS

Compliance with  
ACT 345, P.A. 1990

APPROVED ON: 2-3-99 JS  
OAKLAND COUNTY REMONUMENTATION  
PEER GROUP COMMITTEE  
Register of Deeds Stamp & File Number

4. Lot No. \_\_\_\_\_, Recorded Plat \_\_\_\_\_

5. Private Claims \_\_\_\_\_

I, Joseph C. Kapelczak, in a field survey on March 2, 1998, do hereby certify that under requirements of P.A. 74, Michigan P.A. of 1970, the corner points mentioned in lines 1 and 2 above were in conformance with regulations and rules therefore as required in the current manual of survey instructions of the United States Department of the Interior, Bureau of Land Management or by a decree of a Court of Law and/or that the corner points mentioned in lines 3, 4 and 5 above were in conformance with the rules of the Michigan Board of Land Surveyors or by a Decree of a Court of Law; established, re-established, monumented, re-monumented, recovered, found as expressed below:

NOTE: Not more than 4 corners, all in the same town and range, may be recorded on this certificate.

A. Description of original monument and accessories and/or subsequent restoration:

Set post in 1816 G.L.O. Survey.  
There are no LCRC's recorded at Oakland County.

B. Description of corner evidence found and/or method applied in restoring or reestablishing corner:

Recovered a Delta Surveying capped iron set inside of a 1 1/2" Iron pipe at this location. Validated this location with recovered monumentation from recorded survey L.8793 P.150. One witness from the recorded survey was found and checks with the recovered corner. The corner as found was within 0.30' of the Township Line.

C. Description of monument for corner and accessories established to perpetuate locating the position of the corner:

Set Oakland County Remonumentation Brass Cap stamped #24598.


Set Witnesses:

S 86°E 164.76' Mag nail with OCRT stamped #24598 in south side power pole.  
S 20°E 98.84' Mag nail with OCRT stamped #24598 east side 6" Elm.  
S 86°W 100.34' PK nail with OCRT stamped #24598 north side 6" Elm.  
N 10°E 138.06' Mag nail with OCRT stamped #24598 in east side 6" Cedar.  
A-3 to M-3 Livingston County 134.31'.

	A	B	C	D	E	F	G	H	I	J	K	L	M
2	6	5	4	3	2	1							
3													
4	7	8	9	10	11	12							
5													
6	18	17	16	15	14	13							
7													
8	19	20	21	22	23	24							
9													
10	30	29	28	27	26	25							
11													
12	31	32	33	34	35	36							
13													

900 FILE  
200

2pr

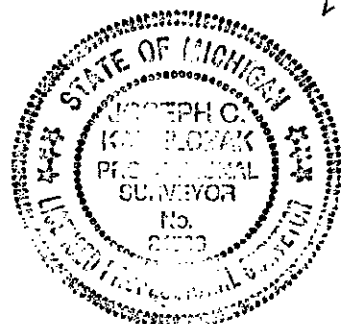

Signed by

*Joseph C. Kapelczak*

Date

1/30/99

Surveyor's Michigan License No. 24598