

MAY 24 2000

DE-4983471

SECTION

LAND CORNER RECORDATION CERTIFICATE, Filing Requirement of Act 74, Mich. P.A. 1970

9.00 MISCELLANEOUS RECORDING
2.00 REMONUMENTATION
4 DEC 98 8:30 A.M. RECEIVED
PAID G. WILLIAM CARROLL - OAKLAND COUNTY
CLERK/REGISTER OF DEEDS

For corners in

Oakland

Located In:

Corner Code #

(County)

1. Public Land Survey	T	4N	R	8E	B-1
	T		R		
	T		R		
	T		R		
2. Property Controlling in Section	S		T	R	
	S		T	R	
3. Miscellaneous Property in Sec.	S		T	R	
	S		T	R	

Compliance with ACT 345, P.A. 1990
APPROVED ON: 7-08-98 JS
OAKLAND COUNTY REMONUMENTATION PEER GROUP COMMITTEE
Register of Deeds Stamp & File Number

4. Lot No. _____, Recorded Plat _____
5. Private Claims _____

A	B	C	D	E	F	G	H	I	J	K	L	M
1												
2	6	5	4	3	2	1						
3												
4	7	8	9	10	11	12						
5												
6	18	17	16	15	14	13						
7												
8	19	20	21	22	23	24						
9												
10	30	29	28	27	26	25						
11												
12	31	32	33	34	35	36						
13												

Grant J. Ward, R.L.S. November 17 97
I, _____, in a field survey on _____, 19____ do hereby state that under requirements of P.A. 74, Michigan P.A. of 1970, the corner points mentioned in lines 1 and 2 above were in conformance with regulations and rules therefore as required in the current manual of survey instructions of the United States Department of the Interior, Bureau of Land Management or by a decree of a Court of Law and /or that the corner points mentioned in lines 3, 4 and 5 above were in conformance with the rules of the Michigan Board of Land Surveyors or by a Decree of a Court of Law; established, re-established, monumented, recovered, found as expressed below.

NOTE: Not more than 2 corners, all in the same town and range, may be recorded on this certificate.

A. Description of original monument and accessories and/or subsequent restoration:

B-1 Post, per G.L.O. Notes.

B. Description of corner evidence found and/or method applied in restoring or reestablishing corner:

B-1 North 1/4 Corner of Section 6, T. 4 N., R. 8 E. Found 5/8 Iron Rod 97.52' West of B-13, Groveland Twp., T. 5 N., R. 8 E.


Previously Recorded in L. 6373 P. 858 (4) of Oakland County Records.

(n) Indicates the number of references that confirms this corner by dimensional tie.

This corner location, although not established by an original government survey, is accepted by the contractor and is generally accepted by professional surveyors as the best available evidence of the position of the original corner.

C. Description of monument for corner and accessories established to perpetuate locating the position of the corner:

B-1	Set 5/8" Iron Rod & Remonumentation Cap.
S 45° E	23.02' Set MAG Nail & Remonumentation Disc in Northeast face of 20" Oak.
S 05° W	28.23' Set MAG Nail & Remonumentation Disc in East face of 25" Maple.
S 40° W	35.36' Set MAG Nail & Remonumentation Disc in Northwest face of 18" Maple.
N 30° W	29.13' Set MAG Nail & Remonumentation Disc in West face of 24" Oak.
East	97.52' Found 5/8" Iron Rod South 1/4 Corner of Section 31, T. 5 N., R. 8 E., Groveland Township.

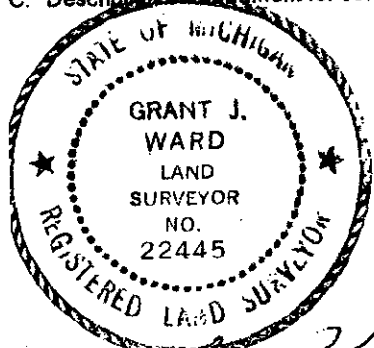

Signed by _____
Surveyor's Michigan License No. 22445

Date April 7, 1998

900 FILE
200