

15709pc013

SEP 29 1995 188804

LAND CORNER RECORDATION CERTIFICATE, 7.00 MISCELLANEOUS RECORDING
Filing Requirement of Act 74, Mich. P.A. 1970, 2.00 REMONUMENTATION

For corners in

Oakland

(County)

Located In:

Corner Code ##

29 SEP 95 7:29 A.M. RECEIPT# 38
PAID RECORDED - OAKLAND COUNTY
LYNN D. ALLEN, CLERK/REGISTER OF DEEDS

1. Public Land Survey T 4N R 9E G-2
T R
T R
T R
2. Property Controlling S T R
in Section S T R
3. Miscellaneous S T R
Property in Sec. S T R

Compliance with
ACT 345, P.A. 1990

APPROVED ON: 9-27-95 JMS
OAKLAND COUNTY REMONUMENTATION
PEER GROUP COMMITTEE

Register of Deeds Stamp & File Number

4. Lot No. , Recorded Plat
5. Private Claims

I, James J. Scharl, in a field survey on 8-9, 19 95,
do hereby certify that under requirements of P.A. 74, Michigan P.A. of 1970, the corner points mentioned
in lines 1 and 2 above were in conformance with regulations and rules therefore as required in the
current manual of survey instructions of the United States Department of the Interior, Bureau of Land
Management or by a decree of a Court of Law and/or that the corner points mentioned in lines 3, 4 and 5
above were in conformance with the rules of the Michigan Board of Land Surveyors or by a Decree of a
Court of Law; established, re-established, monumented, re-monumented, recovered, found as
expressed below:

**NOTE: Not more than 4 corners, all in the same town and range, may be recorded
on this certificate.**

	A	B	C	D	E	F	G	H	I	J	K	L	M
2	6	5	4	3	2	1							
3													
4	7	8	9	10	11	12							
5													
6	16	17	18	19	20	21	22	23	24				
7													
8	19	20	21	22	23	24							
9													
10	30	29	28	27	26	25							
11													
12	31	32	33	34	35	36							
13													

- A. Description of original monument and accessories and/or subsequent restoration:
Post set in 1817 G.L.O. survey; 12" W Oak N 12°W 29 lks, 12" W Oak S 02°W 10 lks
LCRC, L 11235, P 216
Stonerock, 1990, Found 1/2" iron pipe.
*N 50°W 56.34' N/C 16" twin cherry
*East 52.25' face steel fence post
S 41°E 33.58' N/C 12" cherry
*S 75°W 58.87' N/C 28" oak

- B. Description of corner evidence found and/or method applied in restoring or reestablishing corner:
Recovered a 1/2" iron pipe on the centerline extension of extension of
Perry Lake Road to the north and 9' south of the centerline extension of
Shappie Road to the west. A fence line runs east from the corner. A
pinch top pipe and 1/2" rerod were recovered 9.15 ft and 18.15 ft north
of the 1/2" pipe. The locations of the pinch top and rerod were rejected
through lack of supporting evidence.

Witnesses Found


- N 54°E 74.06' Conc. monument
*East 52.15' W/face fence post
*S 75°W 59.58' N/tag N face 30" maple
*N 50°W 55.72' N/tag E face twin 18" cherry

*Confirms LCRC witness

- C. Description of monument for corner and accessories established to perpetuate locating the position of the corner:
Set concrete monument with O.C. remonumentation brass cap, replacing 1/2" iron pipe.

- East 52.15' W face fence post
N 50°W 56.35' PK/remon tag twin 18" cherry
S 75°W 59.60' PK/remon tag N face 30" maple
S 40°E 33.66' PK/remon tag NE face 12" cherry
N 60°E 74.06' concrete monument

The selected location is accepted by the Contractor and is generally accepted by professional
surveyors as the best available evidence of the position of the original corner. This corner
was also accepted by the Oakland County Peer Group as established under Act 345 of P.A. 1990

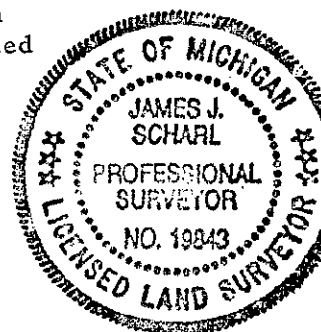

Signed by James J. Scharl Date August 21, 1995
Surveyor's Michigan License No. 19843