

SURVEY & REMONUMENTATION

APR 07 1998

LIBER 17634 PC 853

LAND CORNER RECORDATION CERTIFICATE

Filing Requirement of Act 74, Mich. P.A. 1970

For corners in
Oakland
(County)

Located In: Orion
Twp

Corner Code #

\$ 7.00 MISCELLANEOUS RECORDING

\$ 2.00 REMONUMENTATION

29 SEP 97 12:47 P.M.

RECEIPT# 1478

PAID

RECORDED - OAKLAND COUNTY

LYNN D. ALLEN, CLERK/REGISTER OF DEEDS

Compliance with
ACT 345, P.A. 1990

APPROVED ON: 9-28-97 MS
OAKLAND COUNTY REMONUMENTATION
PEER GROUP COMMITTEE
Register of Deeds Stamp & File Number

- Public Land Survey T 4N R 10E L-7
T R
T R
T R
- Property Controlling S T R
in Section S T R
- Miscellaneous S T R
Property in Section S T R
- Lot No. , Recorded Plat
- Private Claims

I, Huston K. Kennedy, in a field survey on December 1, 19 94, do hereby certify that under requirements of P.A. 74, Michigan P.A. of 1970, the corner points mentioned in lines 1 and 2 above were in conformance with regulations and rules therefore as required in the current manual of survey instructions of the United States Department of the Interior, Bureau of Land Management or by a decree of a Court of Law and/or that the corner points mentioned in lines 3, 4 and 5 above were in conformance with the rules of the Michigan Board of Professional Surveyors or by a Decree of a Court of Law; established, re-established, monumented, re-monumented, recovered, found as expressed below:

NOTE: Not more than 4 corners, all in the same town and range, may be recorded on this certificate.

A. Description of original monument and accessories and/or subsequent restoration:

1817-GLO Wampler, D.S.; Set Post 24" White Oak S04°W 51 Links; 24" White Oak N73°E 57 Links
No recorded or unrecorded LCRCs or recorded or unrecorded surveys

B. Description of corner evidence found and/or method applied in restoring or reestablishing corner:

1994 - Kennedy Surveying, Inc. - Kennedy, PS #17623 - Concrete onument set at the midpoint on a straight line between the Southeast corner and the Southwest corner of Section 24. The corner is 1 foot West of an existing fence, tree & rock row extending to the North & South, also 100 feet Northwest on the D.N.R. Trail intersection No. 4 in the Bald Mountain Recreation Area.

I accept the set concrete monument as the best evidence of the original corner position.

FIELD MEASUREMENTS BETWEEN

K-7 to M-7 5333.95 Ft.
K-7 to M-7 (GLO) 80.40 chains = 5306.40 Ft.
K-7 to L-7 2666.97 Ft.
K-7 to L-7 (GLO) 40.20 chains = 2653.20 Ft.


C. Description of monument for corner and accessories established to perpetuate locating the position of the corner:

L-7 I set a 1/2" Iron Rod encased in a 4" diameter concrete cylinder 36" long w/2" diameter brass cap stamped Oakland County Remonumentation, PS #17623.
N01°E 45.54' Set PK & Remon. Washer West face 21" Cherry
N48°W 35.70' Set PK & Remon. Washer NE face 18" Pine
N88°E 8.90' Set PK & Remon. Washer North face 19" Oak
S28°E 20.80' Set PK & Remon. Washer NE face 22" Oak

The selected location is accepted by me and is generally accepted by Professional Surveyors as the best available evidence of the position of the original corner.

Signed by [Signature]
Surveyor's Michigan License No. 17623

Date December 27, 1994

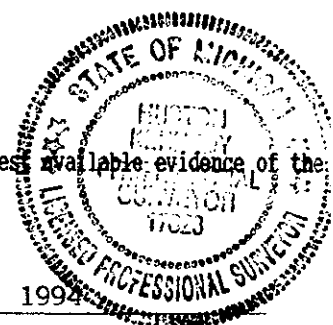

700 FILE
200