

SURVEY & REMONUMENTATION

JAN 20 1995 011224

LIBER 15213 PG 039

MAY - 1 1995

LAND CORNER RECORDATION CERTIFICATE Filing Requirement of Act 74, Mich. P.A. 1970

93-1010
For corners in
Oakland

COMMISSION

OK - T. SMITH

Located In: Oakland Corner Code #

- | | | | | | |
|------------------------------------|---|----|---|-----|-----|
| 1. Public Land Survey | T | 4N | R | 11E | E-2 |
| | T | | R | | |
| | T | | R | | |
| | T | | R | | |
| 2. Property Controlling in Section | S | | T | | R |
| | S | | T | | R |
| 3. Miscellaneous | S | | T | | R |
| Property in Sec. | S | | T | | R |

\$ 9.00 MISCELLANEOUS RECORDING
\$ 2.00 REMONUMENTATION
20 JAN 95 7:43 A.M. RECEIPT# 108
PAID RECORDED - OAKLAND COUNTY
LYNN D. ALLEN, CLERK/REGISTER OF DEEDS
Compliance with
ACT 345, P.A. 1990

APPROVED ON: 2-9-94
OAKLAND COUNTY REMONUMENTATION
PEER GROUP COMMITTEE
Register of Deeds Stamp & File Number

4. Lot No. _____, Recorded Plat _____
5. Private Claims _____

I, Grant J. Ward, RLS, in a field survey on December 21, 1993, do hereby certify that under requirements of P.A. 74, Michigan P.A. of 1970, the corner points mentioned in lines 1 and 2 above were in conformance with regulations and rules therefore as required in the current manual of survey instructions of the United States Department of the Interior, Bureau of Land Management or by a decree of a Court of Law and/or that the corner points mentioned in lines 3, 4 and 5 above were in conformance with the rules of the Michigan Board of Land Surveyors or by a Decree of a Court of Law; established, re-established, monumented, re-monumented, recovered, found as expressed below:

NOTE: Not more than 4 corners, all in the same town and range, may be recorded on this certificate.

A. Description of original monument and accessories and/or subsequent restoration:

E-2 Post, per G.L.O. Notes.

	A	B	C	D	E	F	G	H	I	J	K	L	M
2	6		5		4		3		2		1		
3													
4	7		8		9		10		11		12		
5													
6	18		17		16		15		14		13		
7													
8	19		20		21		22		23		24		
9													
10	30		29		28		27		26		25		
11													
12	31		32		33		34		35		36		
13													

B. Description of corner evidence found and/or method applied in restoring or reestablishing corner:


E-2 Corner common to Sec. 4 and 5, T. 4 N., R. 11 E. Found 1/2" Iron Rod, 0.4' below Road surface, 1.5' East of the Centerline of Lake George Road. This corner location is a careful and faithful perpetuation of the position of the original corner.

Previously Recorded in L. 5805, P. 260 (0); L. 7524, P. 755 (2); L. 8069, P. 476 (3); and L. 8459, P. 426 (3) of Oakland County Records.

C. Description of monument for corner and accessories established to perpetuate locating the position of the corner:

E-2 Corner common to Sec. 4 and 5, T. 4 N., R. 11 E. Set 5/8" Iron Rod and Brass Cap #22445 adjoining Found Iron Rod.

- | | | |
|-----------|--------|---|
| S. 85° E. | 69.02' | Set P.K. Nail & Brass Disc #22445 in N. face of Utility Pole. |
| S. 60° W. | 41.91' | Set P.K. Nail & Brass Disc #22445 SE. face of 14" Ash. |
| N. 79° W. | 37.54' | Set P.K. Nail & Brass Disc #22445 in N. face of 9" Elm. |
| N. 40° W. | 49.85' | Set P.K. Nail & Brass Disc #22445 in NE. face of 12" Elm. |

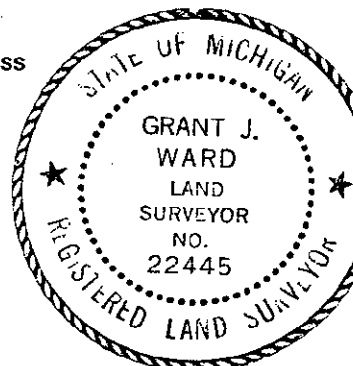

Signed by [Signature]

Date December 15, 1994

Surveyor's Michigan License No. 22445

93-1010