

SURVEY & REMONUMENTATION

JAN 20 1995 011254

MAY - 1 1995

LIBER 15213 PG 099

LAND CORNER RECORDATION CERTIFICATE

OK - T. SMITH

93-1010
For corners in

COMMISSION

Filing Requirement of Act 74, Mich. P.A. 1970

9.00 MISCELLANEOUS RECORDING

\$ 2.00 REMONUMENTATION

20 JAN 95 8:07 A.M. RECEIPT# 12B

PAID RECORDED - OAKLAND COUNTY

LYNN D. ALLEN, CLERK/REGISTER OF DEEDS

Oakland
(County)

Located In: Oakland Corner Code ##

1. Public Land Survey T 4N R 11E H-11
T _____ R _____
T _____ R _____
T _____ R _____
2. Property Controlling S _____ T _____ R _____
in Section S _____ T _____ R _____
3. Miscellaneous S _____ T _____ R _____
Property in Sec. S _____ T _____ R _____

Compliance with
ACT 345, P.A. 1990

APPROVED ON: 12-07-94
OAKLAND COUNTY REMONUMENTATION
PEER GROUP COMMITTEE
Register of Deeds Stamp & File Number

4. Lot No. _____, Recorded Plat _____
5. Private Claims _____

I, Grant J. Ward, RLS, in a field survey on November 10, 19 94, do hereby certify that under requirements of P.A. 74, Michigan P.A. of 1970, the corner points mentioned in lines 1 and 2 above were in conformance with regulations and rules therefore as required in the current manual of survey instructions of the United States Department of the Interior, Bureau of Land Management or by a decree of a Court of Law and/or that the corner points mentioned in lines 3, 4 and 5 above were in conformance with the rules of the Michigan Board of Land Surveyors or by a Decree of a Court of Law; established, re-established, monumented, re-monumented, recovered, found as expressed below:

NOTE: Not more than 4 corners, all in the same town and range, may be recorded on this certificate.

A. Description of original monument and accessories and/or subsequent restoration:

H-11 Post, per G.L.O. Notes.

B. Description of corner evidence found and/or method applied in restoring or reestablishing corner:

H-11 Corner common to Sec. 27 and 34, T. 4 N., R. 11 E. Found Monument level with surface. Fence runs East, West and South. A tree row runs East and West. This corner location is a careful and faithful perpetuation of the position of the original corner.


Previously Recorded in L. 6165, P. 157 (0); L. 10010, P. 617 (4); and L. 10377 P. 369 (3) of Oakland County Records.

(n) Indicates the number of references that confirms this corner by dimensional tie.

C. Description of monument for corner and accessories established to perpetuate locating the position of the corner:

H-11 Corner common to Sec. 27 and 34, T. 4 N., R. 11 E. Set Brass Cap #22445 on Found Monument.

Due West 6.74' Set P.K. Nail & Brass Disc #22445 in S. face of Fence Post.
N. 15° W. 25.30' Set P.K. Nail & Brass Disc #22445 in N. face of 50" Oak.
N. 50° E. 87.37' Set P.K. Nail & Brass Disc #22445 in NW. face of 4" Ash.
Due East 22.67' Set P.K. Nail & Brass Disc #22445 in N. face of 26" Cherry.

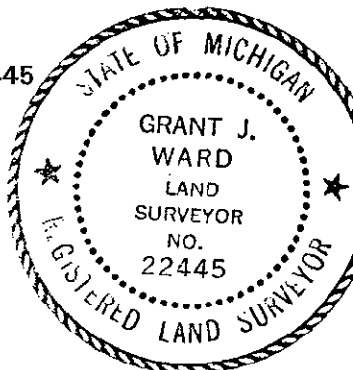

Signed by

Date November 25, 1994

Surveyor's Michigan License No. 22445