

SURVEY & REMONUMENTATION

JAN 20 1995 011274

MAY - 1 1995

LIBER 15213 PG 139

LAND CORNER RECORDATION CERTIFICATE

OK - T. SMITH

93-1010
For corners in

COMMISSION Filing Requirement of Act 74, Mich. P.A. 1970

\$ 9.00 MISCELLANEOUS RECORDING

\$ 2.00 REMONUMENTATION

20 JAN 95 8:10 A.M. RECEIPT# 12B
PAID RECORDED - OAKLAND COUNTY
LYNN D. ALLEN, CLERK/REGISTER OF DEEDS

Oakland
(County)

Located In: Oakland Corner Code ##

- | | | |
|------------------------------------|------------|------|
| 1. Public Land Survey | T 4N R 11E | L-13 |
| | T R | |
| | T R | |
| | T R | |
| 2. Property Controlling in Section | S T R | |
| | S T R | |
| 3. Miscellaneous Property in Sec. | S T R | |
| | S T R | |

Compliance with
ACT 345, P.A. 1990

APPROVED ON: 12-19-94
OAKLAND COUNTY REMONUMENTATION
PEER GROUP COMMITTEE
Register of Deeds Stamp & File Number

4. Lot No. _____, Recorded Plat _____
5. Private Claims _____

I, Grant J. Ward, RLS, in a field survey on January 14, 19 94, do hereby certify that under requirements of P.A. 74, Michigan P.A. of 1970, the corner points mentioned in lines 1 and 2 above were in conformance with regulations and rules therefore as required in the current manual of survey instructions of the United States Department of the Interior, Bureau of Land Management or by a decree of a Court of Law and/or that the corner points mentioned in lines 3, 4 and 5 above were in conformance with the rules of the Michigan Board of Land Surveyors or by a Decree of a Court of Law; established, re-established, monumented, re-monumented, recovered, found as expressed below:

NOTE: Not more than 4 corners, all in the same town and range, may be recorded on this certificate.

A. Description of original monument and accessories and/or subsequent restoration:

L-13 Post, per G.L.O. Notes.

	A	B	C	D	E	F	G	H	I	J	K	L
2	6	5	4	3	2	1						
3												
4	7	8	9	10	11	12						
5												
6	18	17	16	15	14	13						
7												
8	19	20	21	22	23	24						
9												
10	30	29	28	27	26	25						
11												
12	31	32	33	34	35	36						
13												

B. Description of corner evidence found and/or method applied in restoring or reestablishing corner:

L-13 Corner common to Sec. 36 and the Town Line, T. 4 N., R. 11 E. Found 1/2" Iron Rod, 0.2' below Road surface, 1.5' South of the Centerline of Mead Road. Fence is 31' North and 33' South. This corner location is a careful and faithful perpetuation of the position of the original corner.

Previously Recorded in L. 11270, P. 304 (4) of Oakland County Records.


Previously Recorded in L. 7377, P. 746 (L-1 in Avon Twp.) (3); and L. 11996, P. 026 (L-1 in Avon Twp.) (3) of Oakland County Records.

(n) Indicates the number of references that confirms this corner by dimensional tie.

C. Description of monument for corner and accessories established to perpetuate locating the position of the corner:

L-13 Corner common to Sec. 36 and the Town Line, T. 4 N., R. 11 E. Set Iron Rod and Brass Cap adjoining Found 1/2" Iron Rod.

- | | | |
|-----------|--------|--|
| N. 62° E. | 30.35' | Set P.K. Nail & Brass Disc #22445 in SE. face of twin 10" Hickory. |
| S. 65° E. | 37.56' | Set P.K. Nail & Brass Disc #22445 in NE. face of 20" Oak. |
| S. 10° W. | 27.53' | Set P.K. Nail & Brass Disc #22445 in W. face of 24" Oak. |
| N. 52° W. | 37.73' | Set P.K. Nail & Brass Disc #22445 in NE. face of twin 8" Hickory. |
| S. 03° E. | 33.09' | Found Monument. |

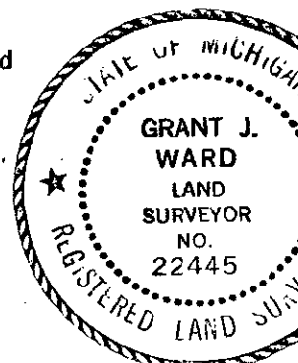

Signed by [Signature]
Surveyor's Michigan License No. 22445

Date December 20, 1994