


T. 5 N. R. 8 E. Groveland Twp. Oakland Co. Mich. SEC. 30

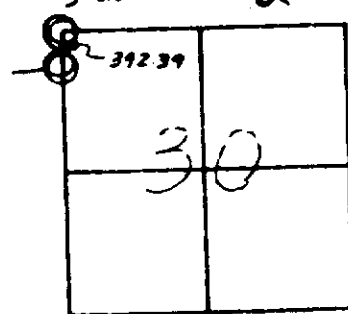


REMARKS

3/4" dia. pipe North edge Grange Hall Rd.
 392.39' North of Section Corner
 common to sections 25 & 24 T 5 N R 7 E.
 MSHD Jan. 1959

WITNESSES

N 100° W	25.82	27" Oak
N 50° E	37.91	Fence Cor.
S 50° E	59.50	17" Hick.
N 65° W	63.65	11" B.E.

MSHD ref. tags set in wit.

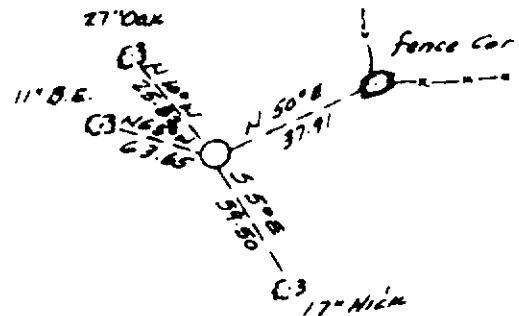

A-9